IREDELL COUNTY HEALTH DEPARTMENT

→ Authorization to Construct 4674686769

STATESVILLE 704-878-5305 MOORESVILLE 704-664-5281

IMPROVEMENT PERMIT / ~~CERTIFICATE OF COMPLETION~~ / OPERATION PERMIT / EXISTING SYSTEM INSPECTION

PROPERTY DESCRIPTION NO. 23108 DATE 2/26/96 TAX MAP NO. 1A - 4 - 58 (26) Watershed: ☐ Yes ☒ No

OWNER OR CONTRACTOR Robert + Leslie Burgess PHONE: Business 664-1922 Home 664-6033

ADDRESS 106 Winter Oak Ln. Mooresville, NC. 28115

LOCATION Patterson Farm Rd. ± .6 mile from 1365 on (L)

SUBDIVISION _____ BLOCK / SECTION _____ LOT _____ LOT AREA ± .99 AC SITE CLASS. P.S DESIGN FLOW 480 L.T.A.R. .2

Septic Tank: 1000 Gallons; STB 794 Date 2/23/96

Pump Tank: _____ Gallons; PT _____ Date _____

Pump Make: _____ Model _____ Serial No. _____

Nitrification Field: No Fields 1 Square Feet 2400 Linear Feet 800 +

No Lines 6 Trench Width 36" Max Trench Bottom Depth 28" Gravel Depth 12"

☒ New System ☐ Repair System Type: I. (II) III. IV. V. VI

System Description: Drop Box - Conventional

Repair System Description: Same

Maintenance Agreement Required: ☐ Yes ☒ No

☐ House/Mod. Home No. Bedrooms 4

☒ Mobile Home No. Bathrooms 2.5

☐ Business No. Employees _____

☐ Other _____

☐ Slab ☒ Crawl Space ☐ Basement w/plumbing ☐ Basement wo/plumbing


Water Supply: ☒ Individual ☐ Community ☐ Public

Comments:

Comments:

INITIAL SITE SKETCH

1" = 50'

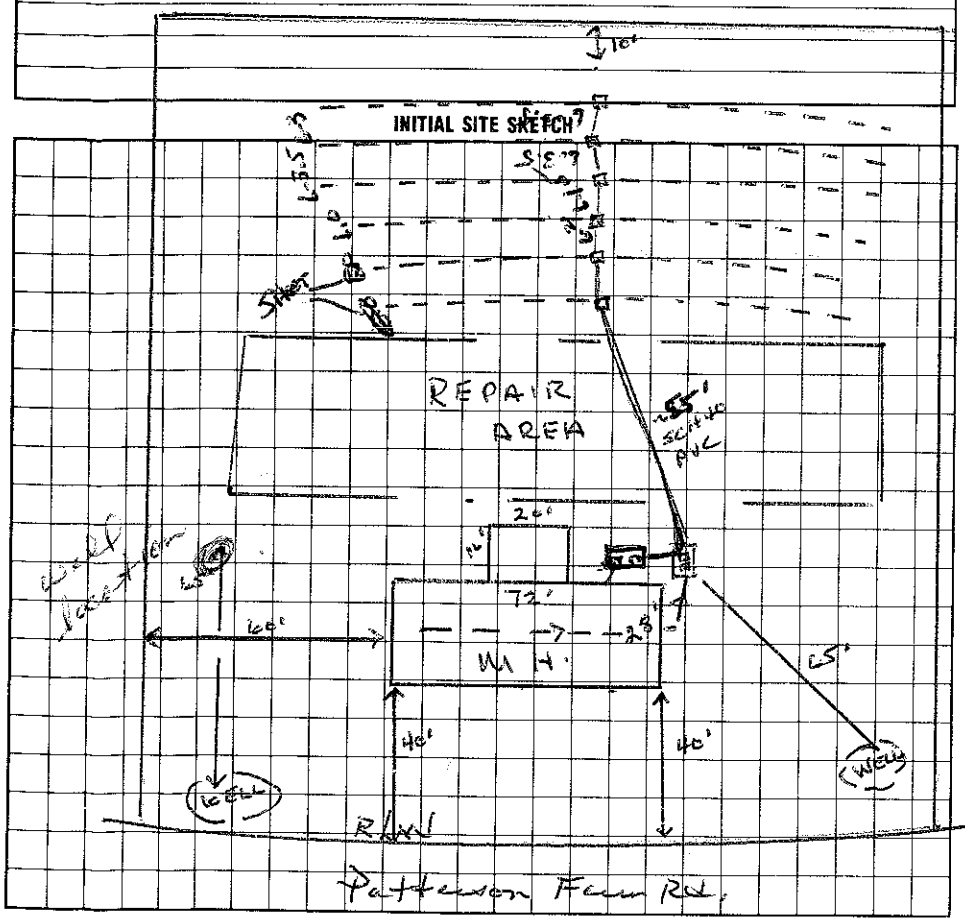

AS BUILT SKETCH

I understand that this permit can be suspended or revoked if any false information is supplied toward securing the permit/any unauthorized changes are made to the site/any unauthorized changes are made in the installation of the system.

Signed: Robert Burgess

Improvement Permit by: Wesley Sparks RS. date 1/27/96

~~Existing System Inspection by:~~ Authorized to Construct Wesley Sparks date 1/27/96

Installed by: Codyco.

Certificate of Completion by: _____ date _____

Operation Permit by: Wesley Sparks RS. date 4/8/96

HEALTH DEPT. COPY: WHITE INSPECTION COPY (FINAL): GREEN OWNER COPY (FINAL): YELLOW INSPECTION COPY (INITIAL): PINK OWNER COPY (INITIAL): GOLD