IREDELL COUNTY HEALTH DEPARTMENT

STATESVILLE 704-878-5305 MOORESVILLE 704-664-5281

IMPROVEMENT PERMIT / CERTIFICATE OF COMPLETION / OPERATION PERMIT / EXISTING SYSTEM INSPECTION

PROPERTY DESCRIPTION NO. 069868 DATE 10/16/97 TAX MAP NO. 4674745659 Watershed: [X] Yes [ ] No

OWNER OR CONTRACTOR Todd BODINE PHONE: Business 933-4274 Home WS II BOW

ADDRESS 10600 ARCHER ROAD DAVIDSON, NC. 28036

LOCATION 1365 TL Lemmond Lake Rd. TL Archer Rd TL 10600 follow driveway down house into pasture

SUBDIVISION NO BLOCK / SECTION LOT LOT AREA ~ 60AC SITE CLASS. PS DESIGN FLOW 480 L.T.A.R. 3

Septic Tank: 1000 Gallons; STB 821 Date 3/9/98
Pump Tank: Gallons; PT Date
Pump Make: Model Serial No.
Nitrification Field: No Fields 1 Square Feet 1600 Linear Feet 535
No Lines 4 Trench Width 36" Max Trench Bottom Depth 36" Gravel Depth 12"

[X] New System [ ] Repair System Type: I (II) III, IV, V, VI
System Description: CONV - DIST BOX
Repair System Description: SAME
Maintenance Agreement Required: [ ] Yes [X] No

[X] House/Mod. Home No. Bedrooms 4
[ ] Mobile Home No. Bathrooms 4.5
[ ] Business No. Employees
[ ] Other
[X] Slab [X] Crawl Space [ ] Basement w/plumbing [ ] Basement wo/plumbing


Water Supply: [X] Individual [ ] Community [ ] Public

Comments:


(REPAIR AREA)

Comments:

INITIAL SITE SKETCH

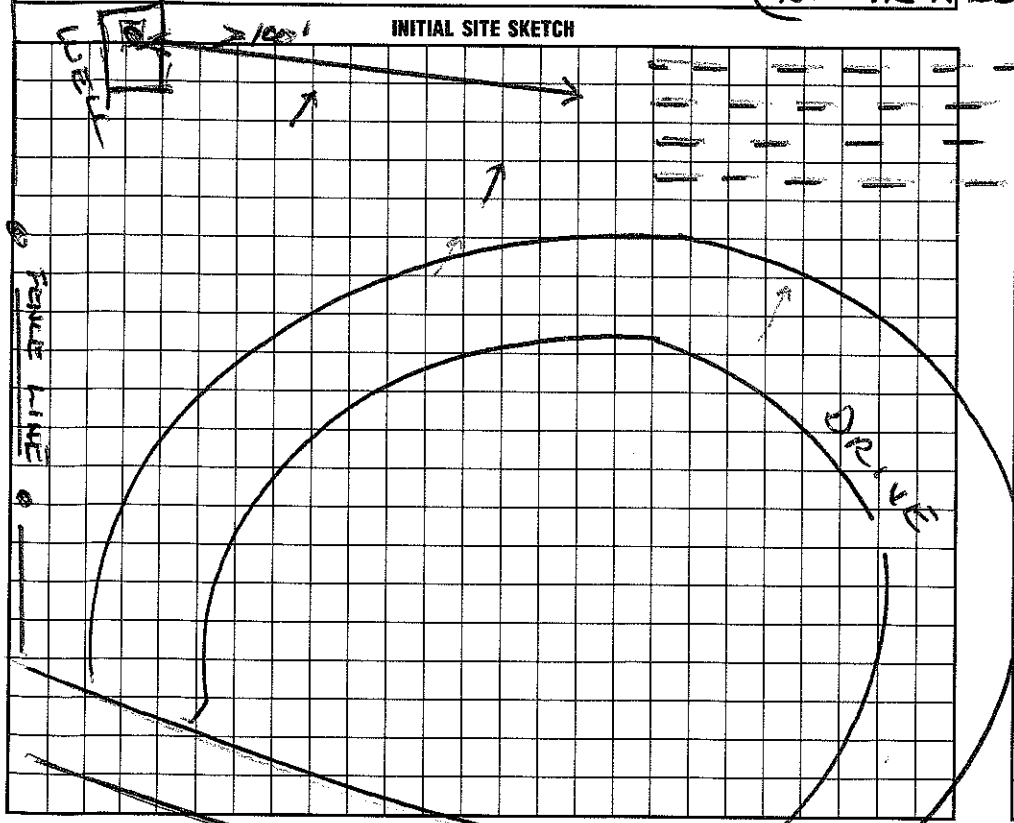

AS BUILT SKETCH

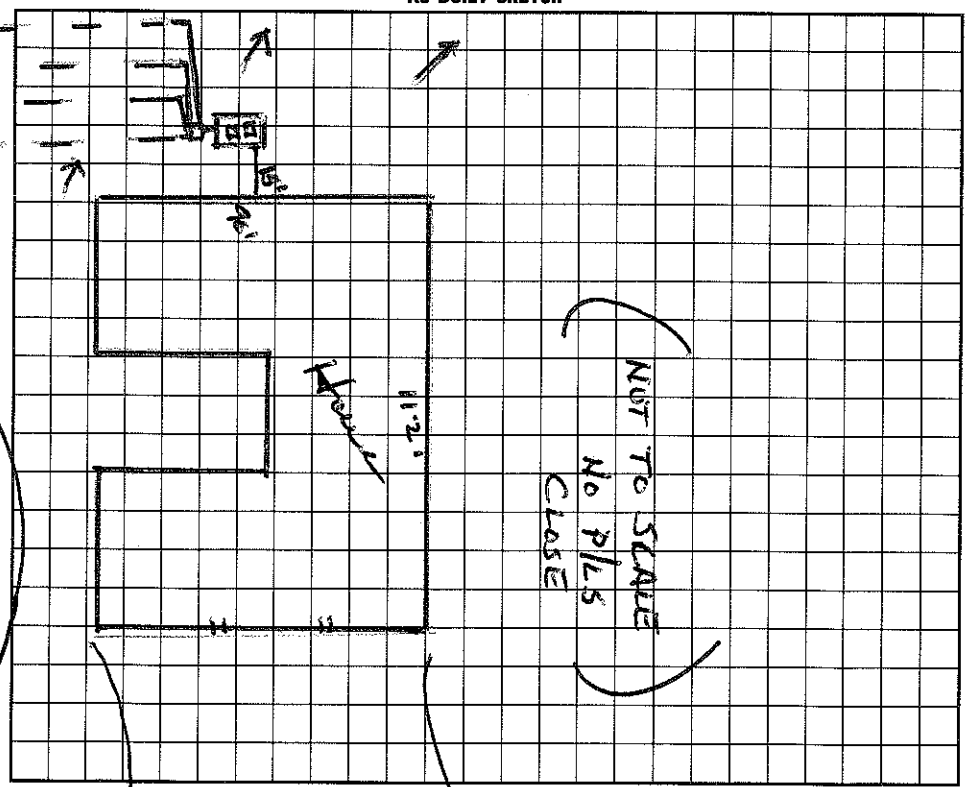

I understand that this permit can be suspended or revoked if any false information is supplied toward securing the permit/any unauthorized changes are made to the site/any unauthorized changes are made in the installation of the system. Improvement Permit is valid for 60 months from date of issuance.

Signed: X Joyce Eblin

Improvement Permit by: Wesley Sparks RS. date 10/16/97

Existing System Inspection by: Wesley Sparks RS date 10/16/97

Installed by: D+M Enterprises

Certificate of Completion by: Wesley Sparks RS. date 4/15/98

Operation Permit by: Wesley Sparks RS date 4/15/98

HEALTH DEPT. COPY: WHITE INSPECTION COPY (FINAL): GREEN OWNER COPY (FINAL): YELLOW INSPECTION COPY (INITIAL): PINK OWNER COPY (INITIAL): GOLD