IREDELL COUNTY HEALTH DEPARTMENT

STATESVILLE 704-878-5305 MOORESVILLE 704-664-5281

IMPROVEMENT PERMIT / AUTHORIZATION TO CONSTRUCT / OPERATION PERMIT (EXISTING SYSTEM INSPECTION)

PERMIT # 153703 PIN # 4674 94 0286 DATE 11/25/08

OWNER or APPLICANT ROBERT BLAND PHONE: Business Home: 704-932-1864

OWNER or APPLICANT ADDRESS DARE DR. DAVIDSON, NC. 28036

LOCATION / DIRECTIONS Hwy 3 SOUTH TL EARNHARDT LAKE TL ARCHER RD. TL DARE DRIVE LAST HOUSE ON (R)

SUBDIVISION No BLOCK / SECTION N/A LOT # LOT AREA ~1AC DESIGN FLOW 360 L.T.A.R. N/A

Septic Tank 1000 Gallons: STB Date

Pump Tank Gallons: P T Date

Pump Make Model EXISTING Serial #

Nitrification Field No Fields No Lines Linear Feet 400

Trench Width Max. Trench Bottom Depth Gravel Depth 12" [X] GRAVITY [ ] PRESSURE

[ ] New System [ ] Repair [ ] Expansion System Type I (II) III IV V VI

System Description:

Repair System Description: EXISTING SYSTEM

Maintenance Agreement Required [ ] YES [ ] NO

[X] Residence No. Bedrooms 3 [ ] Business No. Persons [ ] Other No. Employees [ ] Slab [ ] Crawl Space [ ] Basement w/plumbing [ ] Basement w/o plumbing


Water Supply [X] Private [ ] Public [ ] Community

Comments / Conditions

Comments / Conditions

INITIAL SITE SKETCH

AS BUILT SKETCH

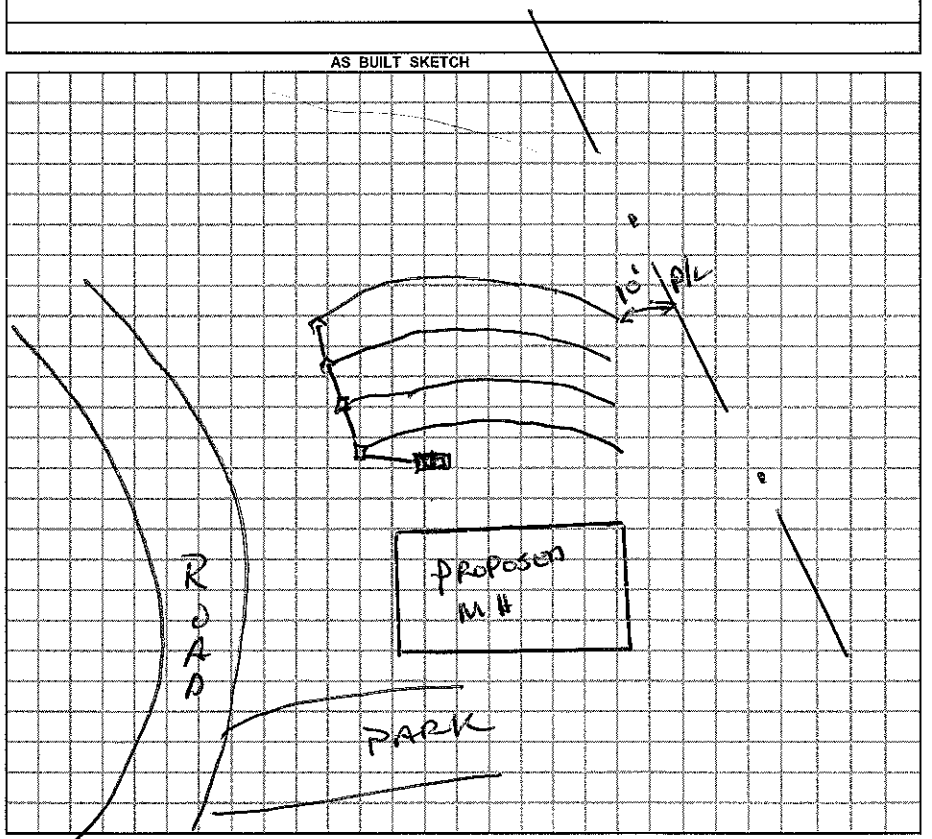

Permit can be suspended or revoked if any false information is supplied toward securing the permit / any unauthorized changes are made to the site / any unauthorized changes are made in the installation of the system.

[ ] *IMPROVEMENT PERMIT w / plat valid without expiration.* [ ] *IMPROVEMENT PERMIT w / site plan valid for 60 mos.* [ ] *AUTHORIZATION TO CONSTRUCT valid for period equal to IMPROVEMENT PERMIT-not to exceed 60 mo.*

Owner / Applicant Signature: Kenneth R Date 11-26-08

Improvement Permit by: Date

Authorization to Construct by: Date

YOU SHOULD CONTACT A LOCATOR SERVICE PRIOR TO ANY EXCAVATION.

Installed by:

Operation Permit by: Date:

Existing System Inspected by: Wesley Sparks R.S. Date: 11/25/08

WHITE COPY Environmental Health YELLOW COPY (Final) Owner / Applicant PINK COPY (Initial) Owner / Applicant