IREDELL COUNTY HEALTH DEPARTMENT

STATESVILLE 704-878-5305 Ø MOORESVILLE 704-664-5281

IMPROVEMENT PERMIT / AUTHORIZATION TO CONSTRUCT / OPERATION PERMIT / EXISTING SYSTEM INSPECTION

PERMIT# 126085 PIN# ~~4674-94-0693~~ 4674941512 DATE 2/3/05

OWNER OR CONTRACTOR Robert Bland PHONE: Business _____ Home 932-1864

ADDRESS 6764 Dare Dr. Davidson NC 28036

LOCATION HWY 3 S, TL Beaty Ford Lake Rd, TL Archer, TL Dare To end.

SUBDIVISION _____ BLOCK / SECTION _____ LOT _____ LOT AREA ~~2~~ 7 Ac SITE CLASS. PS DESIGN FLOW 240 L.T.A.R. 0.35

Septic Tank: 1000 Gallons; STB 794 Date 6/2/04

Pump Tank: _____ Gallons; PT _____ Date _____

Pump Make: _____ Model _____ Serial No. _____

Nitrification Field: No Fields 1 Square Feet 720 Linear Feet 240

No Lines 4@60' Trench Width 36" Max Trench Bottom Depth 36" Gravel Depth 12"

☒ New System ☐ Repair System Type: I, II, III, IV, V, VI

System Description: Gravity Conventional

Repair System Description: Same

Maintenance Agreement Required: ☐ Yes ☒ No

☒ House/Mod. Home ☐ Mobile Home ☐ Business ☐ Other

No. Bedrooms 3 No. Bathrooms ____ No. Employees ____


☐ Slab ☒ Crawl Space ☐ Basement w/plumbing ☐ Basement wo/plumbing

Water Supply: ☒ Individual ☐ Public ☐ Community Existing

Comments:/Conditions: ~~Shared~~ Well

Comments:/Conditions:

INITIAL SITE SKETCH

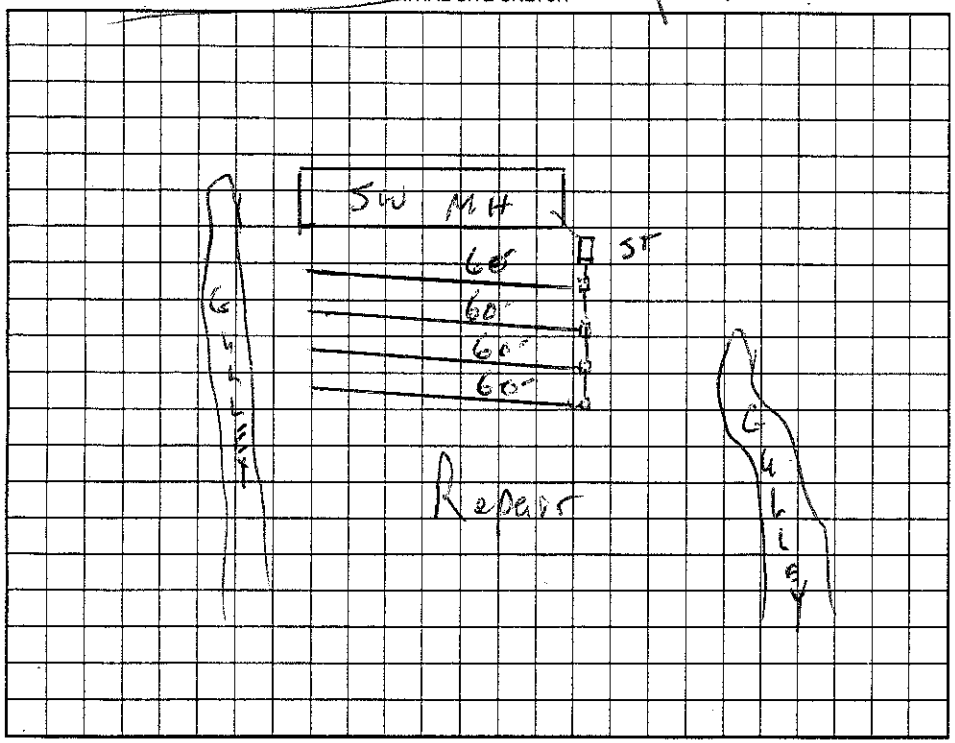

AS BUILT SKETCH

Permit can be suspended or revoked if any false information is supplied toward securing the permit/any unauthorized changes are made to the site/any unauthorized changes are made in the installation of the system. Improvement Permit with plat valid without expiration. Improvement Permit with site plan valid for sixty months. Authorization to Construct is valid for a period equal to that of Improvement Permit – not to exceed sixty months.

Signed: Robert E. Bland date 2-4-05 Installed by: Lewon Bentley

Improvement Permit by: RS date 2/3/05 Operation Permit by: Wesley Parker RS date 5/3/05

Authorization to Construct by: RS date 2/3/05 Existing System Inspection by: _____ date _____

HEALTH DEPT. COPY: WHITE OWNER COPY (FINAL): YELLOW OWNER COPY (INITIAL): PINK