IREDELL COUNTY HEALTH DEPARTMENT

STATESVILLE 704-878-5305 MOORESVILLE 704-664-5281

IMPROVEMENT PERMIT / CERTIFICATE OF COMPLETION / OPERATION PERMIT / EXISTING SYSTEM INSPECTION

PROPERTY DESCRIPTION NO. 18393 DATE 5/9/94 TAX MAP NO. 1E 3B 18 Watershed: ☑ Yes ☐ No

OWNER OR CONTRACTOR James W Carson PHONE: Business 4615-07-6877 Home 664-4449

ADDRESS 1035 Malone St. Mooresville, NC. 28115

LOCATION Vick Rd, 1365 TR Rocky River Church on Vick, ~, 1 mile on (L)

SUBDIVISION VA Johnson BLOCK / SECTION ____ LOT 18 LOT AREA 200'x100' SITE CLASS. P DESIGN FLOW 240 L.T.A.R. .12-.25

Septic Tank: 1000 Gallons; STB 795 Date 4-7-94

Pump Tank: ____ Gallons; PT ____ Date ____

Pump Make: ____ Model ____ Serial No. 3/10 HP

Nitrification Field: No Fields 1 Square Feet 960 Linear Feet 320

No Lines 5 Trench Width 3' Max Trench Bottom Depth 28" Gravel Depth ____

☑ New System ☐ Repair System Type: I, II, III, IV, V, VI

System Description: DROP BOX - CONV.

Repair System Description: SAME

Maintenance Agreement Required: ☐ Yes ☑ No

☐ House/Mod. Home No. Bedrooms 2

☑ Mobile Home No. Bathrooms 1.5

☐ Business No. Employees ____

☐ Other ____

☐ Slab ☑ Crawl Space ☐ Basement w/plumbing ☐ Basement wo/plumbing

Water Supply: ☑ Individual ☐ Community ☐ Public


Comments:

Trench depth no greater than 28" to trench bottom.

Comments:

Installed as shown.

INITIAL SITE SKETCH

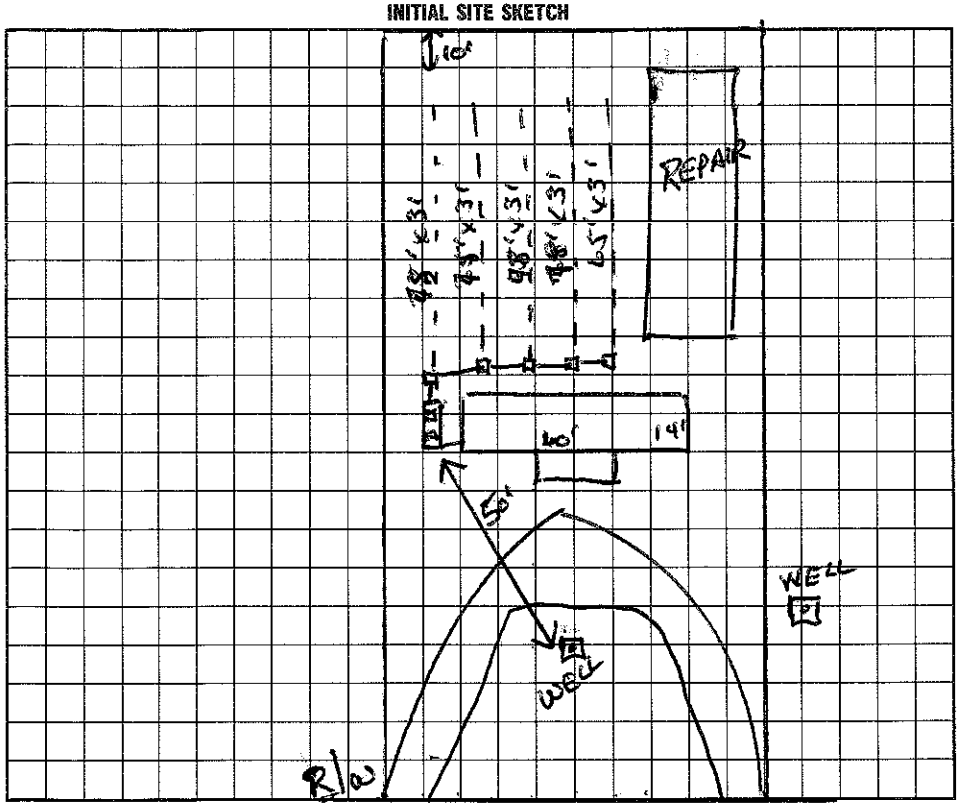

AS BUILT SKETCH

I understand that this permit can be suspended or revoked if any false information is supplied toward securing the permit/any unauthorized changes are made to the site/any unauthorized changes are made in the installation of the system. Improvement Permit is valid for 60 months from date of issuance.

Signed: x James W Carson

Improvement Permit by: Wesley Sparks RS. date 5/9/94

Existing System Inspection by: ____ date ____

Installed by: Levon Benton

Certificate of Completion by: Wesley Sparks RS date 5/25/94

Operation Permit by: ____ date ____

HEALTH DEPT. COPY: WHITE INSPECTION COPY (FINAL): GREEN OWNER COPY (FINAL): YELLOW INSPECTION COPY (INITIAL): PINK OWNER COPY (INITIAL): GOLD