IREDELL COUNTY HEALTH DEPARTMENT

STATESVILLE 704-878-5305 MOORESVILLE 704-664-5281

IMPROVEMENT PERMIT / AUTHORIZATION TO CONSTRUCT / OPERATION PERMIT / EXISTING SYSTEM INSPECTION

PERMIT# 076827 PIN# 4675079730

OWNER OR CONTRACTOR Barbara & Godfrey Eason PHONE: Business (704) 663-4390 Home DATE 10/22/98

ADDRESS 835 Pepperidge Rd Westbury, NY 11590

LOCATION Hwy 136 S TR Rocky River Rd - L Vick Rd ~200' on Rt

SUBDIVISION BLOCK / SECTION LOT LOT AREA .44 Acre SITE CLASS. Existing DESIGN FLOW L.T.A.R.

Septic Tank: Existing Gallons; STB Date

Pump Tank: Gallons; PT Date

Pump Make: Model Serial No.

Nitrification Field: No. Fields Square Feet Linear Feet 225'

No Lines ~~2~~ Trench Width 24" NG Max Trench Bottom Depth Gravel Depth

☐ New System ☐ Repair System Type: I, II, III, IV, V, VI

System Description: Existing System

Repair System Description:

Maintenance Agreement Required: ☐ Yes ☐ No

☐ House/Mod. Home No. Bedrooms 3

☒ Mobile Home No. Bathrooms 2

☐ Business No. Employees

☐ Other


☐ Slab ☒ Crawl Space ☐ Basement w/plumbing ☐ Basement wo/plumbing

Water Supply: ☒ Individual ☐ Public ☐ Community

Comments:/Conditions: Replacing 3 Bedroom MH with 3 Bedroom. Existing Septic System appears to be functioning Okay at time of inspection, No problems Noticed.

Comments:/Conditions: ~~X~~ Must keep New MH at least 5 ft. from Existing Septic System. Original permit 10/20/72

INITIAL SITE SKETCH

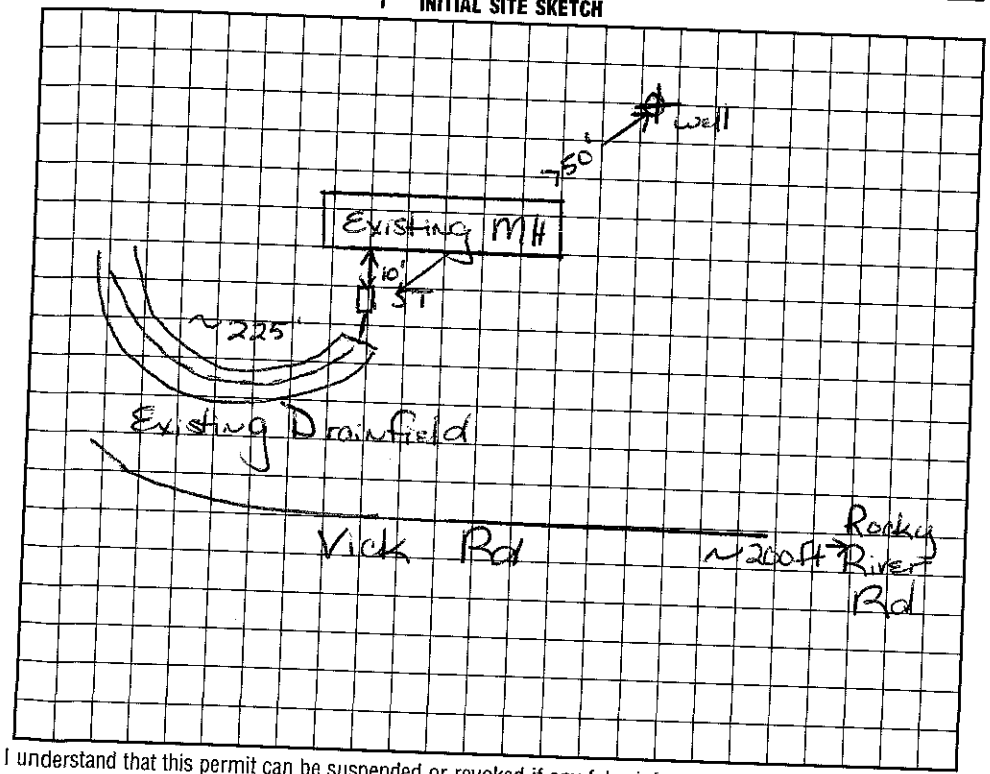

AS BUILT SKETCH

I understand that this permit can be suspended or revoked if any false information is supplied toward securing the permit/any unauthorized changes are made to the site/any unauthorized changes are made in the installation of the system. Improvement Permit with plat valid without expiration. Improvement Permit with site plan valid for sixty months. Authorization to Construct is valid for a period equal to that of Improvement Permit – not to exceed sixty months.

Signed: X Barbara - Godfrey Eason

Improvement Permit by: date

Authorization to Construct by: Maria H. Dotson R.S. date 10/22/98

Installed by:

Operation Permit by: date

Existing System Inspection by: Maria Dotson date 10/22/98

HEALTH DEPT. COPY: WHITE INSPECTION COPY (FINAL): GREEN OWNER COPY (FINAL): YELLOW INSPECTION COPY (INITIAL): PINK OWNER COPY (INITIAL): GOLD