IREDELL COUNTY HEALTH DEPARTMENT

Statesville Phone TR 3-7271 Mooresville Phone NO 3-1271

PERMIT TO INSTALL SEPTIC TANK

Permit NO. 239 Permit Date 10-26-1972

Owner Tom Allison Address Mooresville

Installed By E.J. Ervin Address Mooresville


Location of Property Bird Land off Rt 1147

Tank		Capacity		Length of Lines		Fixtures	
Block	( )	1000	( )	225'	(✓)	No. of Baths	(2)
Precast	(✓)	1250	( )	250'	( )	Dishwasher	(no)
		1500	( )	Other		Garbage Grdr.	(no)
		Other				Other	washing machine

NOTIFY HEALTH DEPARTMENT AT LEAST EIGHT HOURS BEFORE TANK IS TO BE INSPECTED.

Final Inspection 10-26-1972 Approved (✓) Disapproved ( )

Remarks Existing Tank added 5 standard line

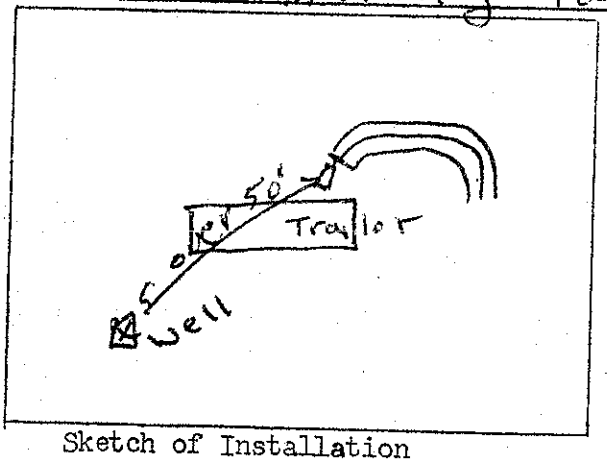

Sketch of Installation

J. C. Moore

Sanitarian