IREDELL COUNTY HEALTH DEPARTMENT

STATESVILLE 704-878-5305 MOORESVILLE 704-664-5281

IMPROVEMENT PERMIT / AUTHORIZATION TO CONSTRUCT / OPERATION PERMIT / EXISTING SYSTEM INSPECTION

PERMIT# 19450 PIN# IE 3B 27 4075079865

OWNER OR CONTRACTOR Woody J. Allison PHONE: Business

ADDRESS 413 Holt St. Lexington, NC. 27292 Home 246-5746

DATE 10/22/98

LOCATION 1365 TR Rocky River Rd TL Vick Rd. corner lot on (R)

SUBDIVISION IE-3 BLOCK / SECTION LOT 27 LOT AREA .46 Ac SITE CLASS. P5 DESIGN FLOW 360 L.T.A.R. .25

Septic Tank: 1000 Gallons; STB T-4 Date 9/2/98

Pump Tank: Gallons; PT Date

Pump Make: Model Serial No.

Nitrification Field: No Fields 1 Square Feet 930 Linear Feet ~~330~~ 310

No Lines 3 Trench Width 36" Max Trench Bottom Depth 30" Gravel Depth SAND

☒ New System ☐ Repair System Type: I, II, (III) IV, V, VI

System Description: GRAY - PPBS

Repair System Description: SAME

Maintenance Agreement Required: ☐ Yes ☒ No

☒ House/Mod. Home No. Bedrooms 3

☐ Mobile Home No. Bathrooms 2

☐ Business No. Employees

☐ Other


☐ Slab ☐ Crawl Space ☐ Basement w/plumbing ☐ Basement wo/plumbing

Water Supply: ☒ Individual ☐ Public ☐ Community

Comments:/Conditions:


Comments:/Conditions: 240' - Ch PLASTIC
70' - 16" PPBS (ADDED)

INITIAL SITE SKETCH

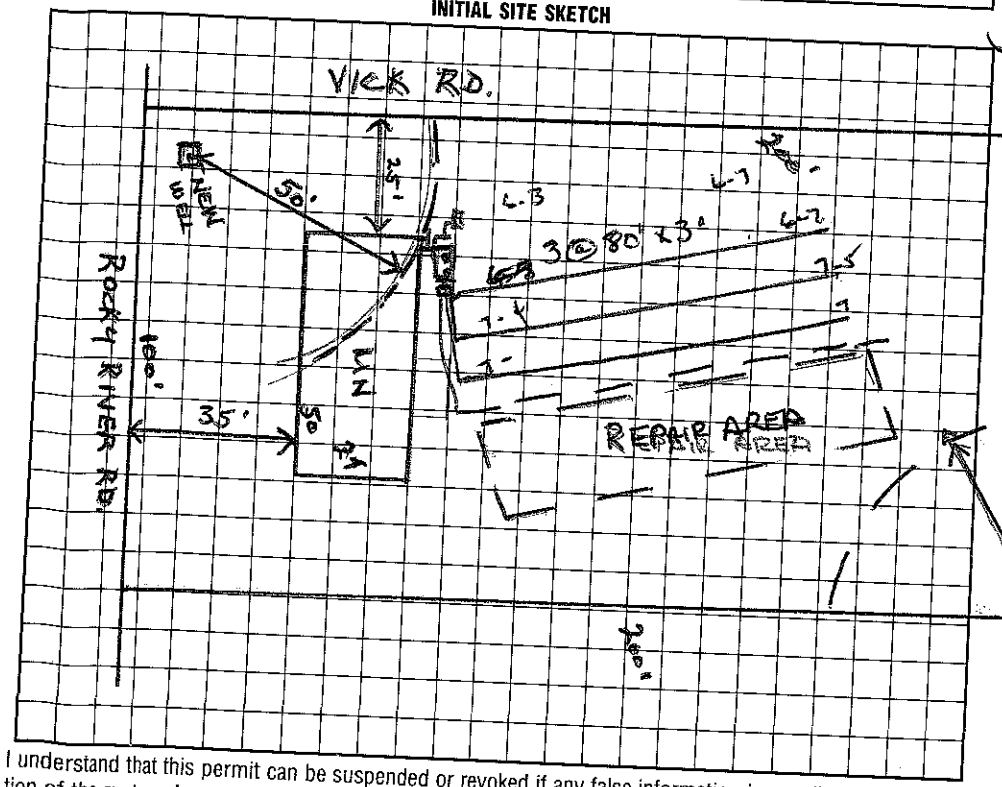

1" = 40'

AS BUILT SKETCH

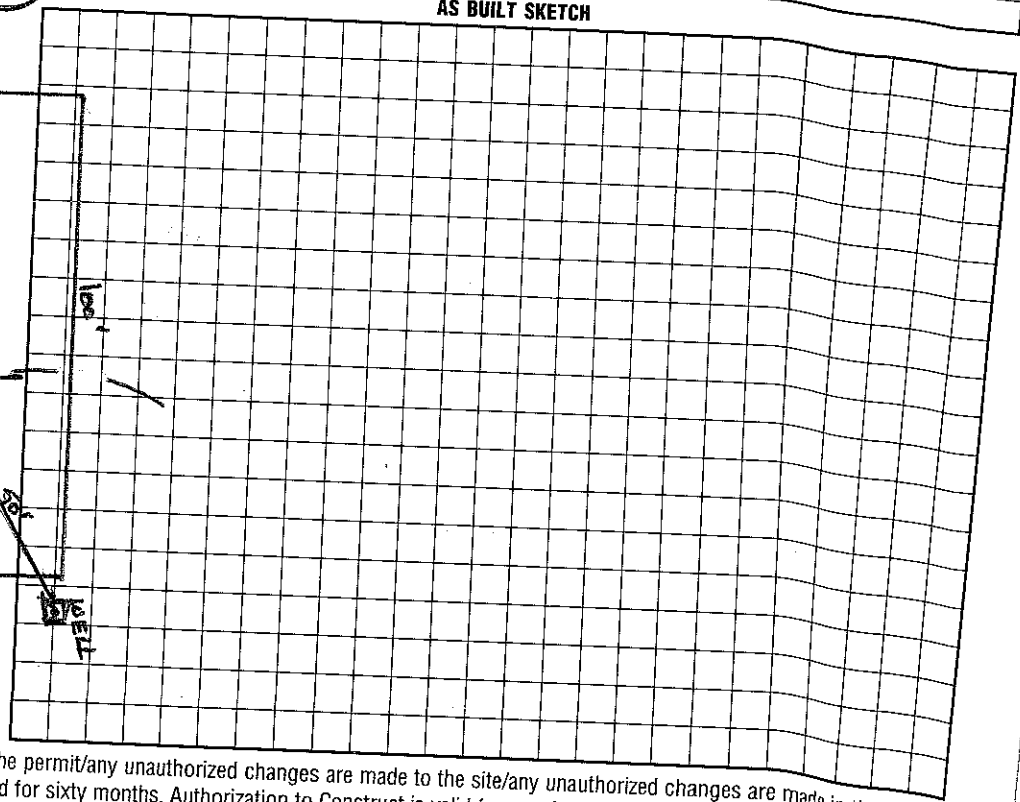

I understand that this permit can be suspended or revoked if any false information is supplied toward securing the permit/any unauthorized changes are made to the site/any unauthorized changes are made in the installation of the system. Improvement Permit with plat valid without expiration. Improvement Permit with site plan valid for sixty months. Authorization to Construct is valid for a period equal to that of Improvement Permit – not to exceed sixty months.

Signed: Woody J. Allison date 4/27

Improvement Permit by: Wesley Sparks R.S. date 10/22/98

Authorization to Construct by: Wesley Sparks R.S. date 10/22/98

Installed by: A Conrad is Grading

Operation Permit by: Wesley Sparks date 11/24/98

Existing System Inspection by: date

HEALTH DEPT. COPY: WHITE INSPECTION COPY (FINAL): GREEN OWNER COPY (FINAL): YELLOW INSPECTION COPY (INITIAL): PINK OWNER COPY (INITIAL): GOLD