IREDELL COUNTY HEALTH DEPARTMENT

STATESVILLE 704-878-5305 MOORESVILLE 704-664-5281

IMPROVEMENT PERMIT / AUTHORIZATION TO CONSTRUCT / OPERATION PERMIT / EXISTING SYSTEM INSPECTION

PERMIT# 1040520 PIN# 4615141998 DATE

OWNER OR CONTRACTOR Will Jones PHONE: Business Home 660-5569

ADDRESS 239 Hawksprey Dr. Mooresville, NC. 28115

LOCATION 1365 TR Hawksprey (R) fork to shop on left before last house

SUBDIVISION No BLOCK / SECTION LOT LOT AREA 10 ac. SITE CLASS. DESIGN FLOW 450GPD L.T.A.R.

Septic Tank: EXISTING Gallons; STB Date

Pump Tank: Gallons; PT Date

Pump Make: Model Serial No.

Nitrification Field: No Fields Square Feet ~~Linear~~ Feet

No Lines Trench Width Max Trench Bottom Depth Gravel Depth

☐ New System ☐ Repair System Type: I (II) III, IV, V, VI

System Description: Existing System.

Repair System Description:

Maintenance Agreement Required: ☐ Yes ☒ No

☐ House/Mod. Home No. Bedrooms

☐ Mobile Home No. Bathrooms

☐ Business No. Employees

☒ Other 80'x40' Shop Bldg.


☒ Slab ☐ Crawl Space ☐ Basement w/plumbing ☐ Basement wo/plumbing

Water Supply:
☒ Individual
☐ Public
☐ Community


Comments:/Conditions:

Comments:/Conditions:

INITIAL SITE SKETCH

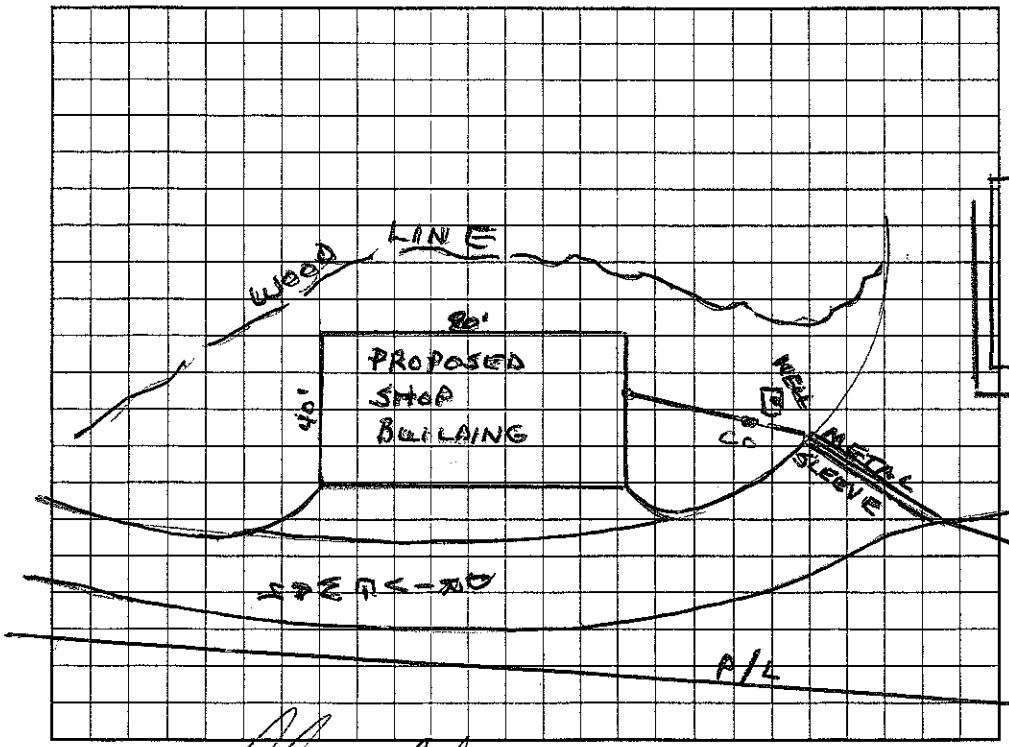

AS BUILT SKETCH

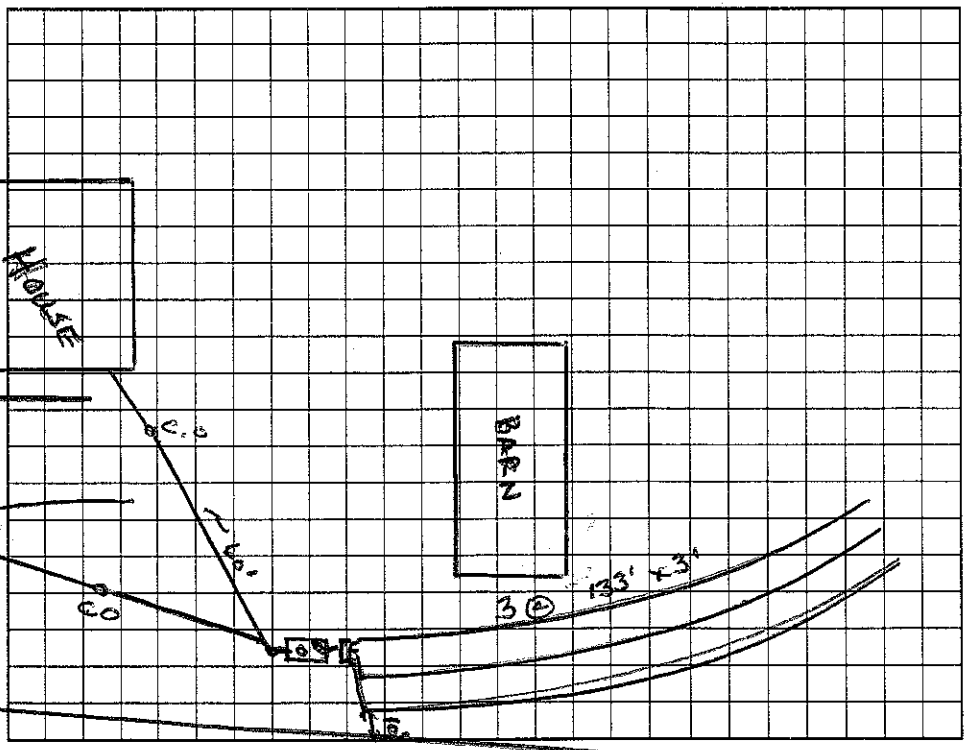

Permit can be suspended or revoked if any false information is supplied toward securing the permit/any unauthorized changes are made to the site/any unauthorized changes are made in the installation of the system. Improvement Permit with plat valid without expiration. Improvement Permit with site plan valid for sixty months. Authorization to Construct is valid for a period equal to that of Improvement Permit – not to exceed sixty months.

Signed: date

Improvement Permit by: date

Authorization to Construct by: date

Installed by:

Operation Permit by: date

Existing System Inspection by: Wesley Sparks RS. date 1/16/02

HEALTH DEPT. COPY: WHITE OWNER COPY (FINAL): YELLOW OWNER COPY (INITIAL): PINK