IREDELL COUNTY HEALTH DEPARTMENT

STATESVILLE 704-878-5305 MOORESVILLE 704-664-5281

IMPROVEMENT PERMIT / CERTIFICATE OF COMPLETION / OPERATION PERMIT / EXISTING SYSTEM INSPECTION

PROPERTY DESCRIPTION NO. Repair DATE 6/14/96 TAX MAP NO. 4675-20-1351 Watershed: ☐ Yes ☑ No

OWNER OR CONTRACTOR Kimberly Vick PHONE: Business _____ Home 664-9269

ADDRESS 147 Louise Dr. Mooresville NC 28115

LOCATION ~~#65~~ #147 Louise Dr - I-365 - TR ~~Court~~ Johnson Dairy - TR ~~Carolwood~~ Carolwoods - TR Louise Dr. ≈.5mile on Lt.

SUBDIVISION Carolwoods BLOCK / SECTION _____ LOT 24 LOT AREA _____ SITE CLASS. PS DESIGN FLOW 360 L.T.A.R. 13 gal

Septic Tank: Existing Gallons; STB _____ Date _____

Pump Tank: _____ Gallons; PT _____ Date _____

Pump Make: _____ Model _____ Serial No. _____

Nitrification Field: No Fields 1 Square Feet 270 Linear Feet 90

No Lines 1 Trench Width 36" Max Trench Bottom Depth 36" Gravel Depth 12"

☑ New System ☑ Repair System Type: I, II, III, IV, V, VI

System Description: (Gravity, Conventional)

Repair System Description: _____

Maintenance Agreement Required: ☐ Yes ☑ No

☐ House/Mod. Home No. Bedrooms 3

☑ Mobile Home No. Bathrooms 2

☐ Business No. Employees _____

☐ Other _____


☐ Slab ☑ Crawl Space ☐ Basement w/plumbing ☐ Basement wo/plumbing

Water Supply: ☑ Individual ☐ Community ☐ Public

Comments: Cut off old ~~line~~ failing line. Add distribution box in place of Drop boxes if possible. Tank needs pumping.

Comments:

INITIAL SITE SKETCH

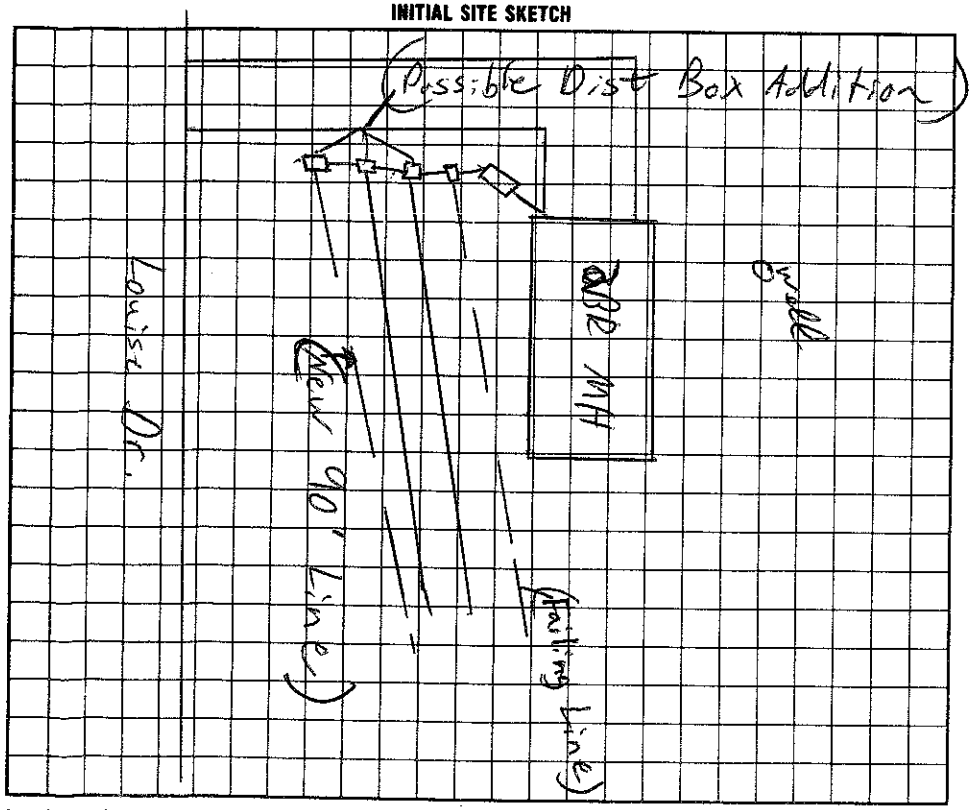

AS BUILT SKETCH

I understand that this permit can be suspended or revoked if any false information is supplied toward securing the permit/any unauthorized changes are made to the site/any unauthorized changes are made in the installation of the system.

Signed: Kimberly C. Vick

Improvement Permit by: [signature] EHS date 6/14/96

Existing System Inspection by: [signature] EHS date 6/14/96

Installed by: J + M Enterprises

Certificate of Completion by: _____ date _____

Operation Permit by: Wesley Sparks RS. date 6/19/96

HEALTH DEPT. COPY: WHITE INSPECTION COPY (FINAL): GREEN OWNER COPY (FINAL): YELLOW INSPECTION COPY (INITIAL): PINK OWNER COPY (INITIAL): GOLD