IREDELL COUNTY HEALTH DEPARTMENT

STATESVILLE 704-878-5305 MOORESVILLE 704-664-5281

IMPROVEMENT PERMIT / CERTIFICATE OF COMPLETION / OPERATION PERMIT / EXISTING SYSTEM INSPECTION

PROPERTY DESCRIPTION NO. 19596 DATE 10/26/94 TAX MAP NO. 13-1-13 7 Watershed: ☑ Yes ☐ No

OWNER OR CONTRACTOR Doug Morton PHONE: Business 528-5113 Home

ADDRESS PO Box 1363 Troutman, NC. 28166

LOCATION 4675-20-8345

SUBDIVISION Hunter Woods BLOCK / SECTION 1 LOT 7 LOT AREA ~1/2 Ac SITE CLASS. P DESIGN FLOW 360 L.T.A.R. .25

Septic Tank: 1000 EXISTING Gallons; STB 54 STR Date

Pump Tank: Gallons; PT Date

Pump Make: Model Serial No.

Nitrification Field: No Fields 1 Square Feet 1200 Linear Feet 400

No Lines 8 Trench Width 36" Max Trench Bottom Depth Gravel Depth

☐ New System ☐ Repair System Type: I, II, III, IV, V, VI

System Description: Existing System

Repair System Description:

Maintenance Agreement Required: ☐ Yes ☑ No

☑ House/Mod. Home No. Bedrooms 3

☐ Mobile Home No. Bathrooms 2

☐ Business No. Employees

☐ Other Existing System

☐ Slab ☐ Crawl Space ☐ Basement w/plumbing ☐ Basement w/o/plumbing


Water Supply: ☑ Individual ☐ Community ☐ Public

Comments:

Adding 24' x 33' Garage

Comments:

~~INITIAL SITE SKETCH~~ As built sketch

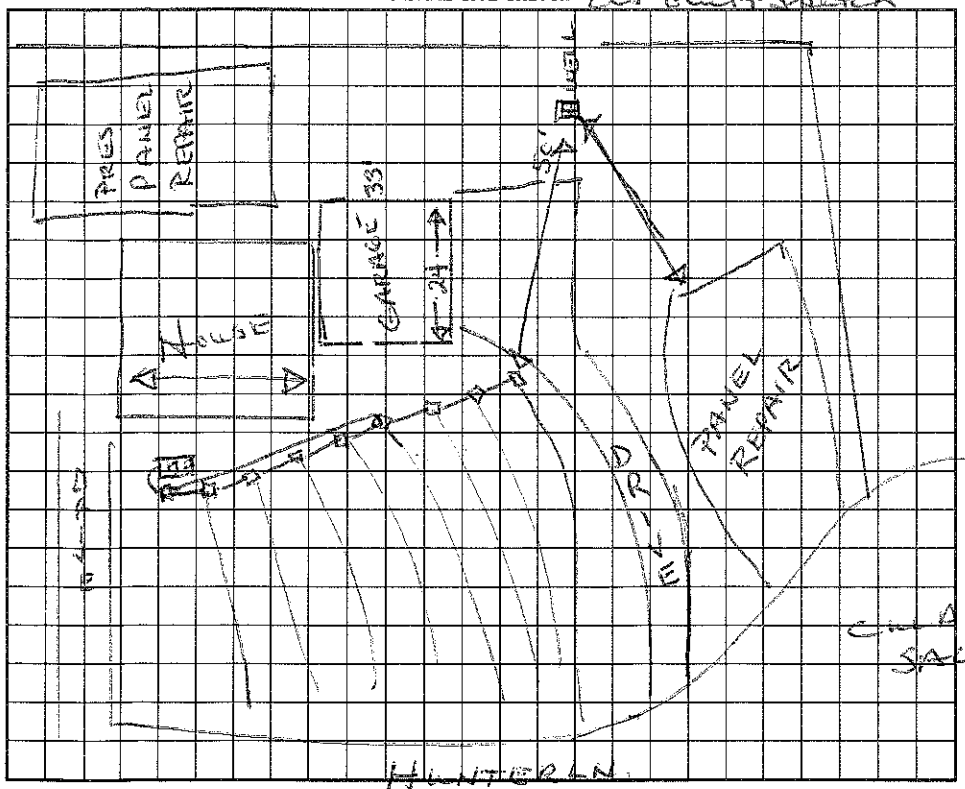

AS BUILT SKETCH

I understand that this permit can be suspended or revoked if any false information is supplied toward securing the permit/any unauthorized changes are made to the site/any unauthorized changes are made in the installation of the system. Improvement Permit is valid for 60 months from date of issuance.

Signed:

Improvement Permit by: date

Existing System Inspection by: Wesley Sparks RS date 10/26/94

Installed by:

Certificate of Completion by: date

Operation Permit by: date

HEALTH DEPT. COPY: WHITE INSPECTION COPY (FINAL): GREEN OWNER COPY (FINAL): YELLOW INSPECTION COPY (INITIAL): PINK OWNER COPY (INITIAL): GOLD