IREDELL COUNTY HEALTH DEPARTMENT

STATESVILLE 704-878-5305 MOORESVILLE 704-664-5281

IMPROVEMENT PERMIT / AUTHORIZATION TO CONSTRUCT / OPERATION PERMIT / EXISTING SYSTEM INSPECTION

PERMIT # 175870 PIN # ~~4675243900~~ 4675256068 DATE 11-27-12

OWNER or APPLICANT Abby Helms PHONE: Business 704-239-3693 Home: N/A

~~OWNER or~~ APPLICANT ADDRESS 107 Hawks Prey Dr.

LOCATION / DIRECTIONS Hwy 3 TR Hawks Prey Dr. 163 Hawks Prey Dr., Mrsvl. 28115


~~SUBDIVISION~~ N/A BLOCK / SECTION N/A LOT # N/A LOT AREA 15.36 acres DESIGN FLOW 360 gpd L.T.A.R. 0.25

Septic Tank 1000	Gallons: STB	Date	☑ New System ☐ Repair ☐ Expansion System Type I II III IV V VI	☑ Residence	No. Bedrooms 3	Water Supply
Pump Tank	Gallons: PT	Date	System Description: 25% Reduction	☐ Business	No. Persons	☑ Private
Pump Make	Model	Serial #	Repair System Description: 25% Reduction	☐ Other	No. Employees	☐ Public
Nitrification Field No Fields 1	No Lines 3	Linear Feet 360	Maintenance Agreement Required ☐ YES ☑ NO	☐ Slab	☑ Crawl Space	☐ Community
Trench Width 36"	Max. Trench Bottom Depth 36"	Gravel Depth N/A	☑ GRAVITY ☐ PRESSURE	☐ Basement w/plumbing	☐ Basement w/o plumbing	

Comments / Conditions: Install a 25% reduction system on contour with serial distribution. Well is 100' away from existing septic system for existing house + +100' from new system area.

Comments / Conditions

INITIAL SITE SKETCH

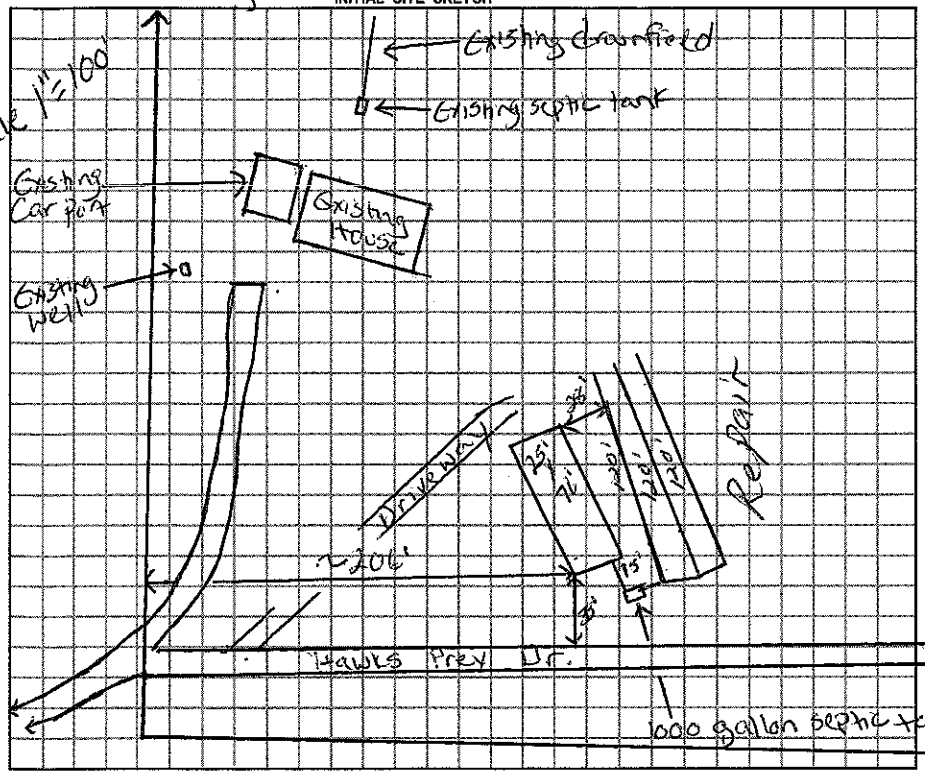

AS BUILT SKETCH

SEE AS BUILT

Permit can be suspended or revoked if any false information is supplied toward securing the permit / any unauthorized changes are made to the site / any unauthorized changes are made in the installation of the system.

☐ IMPROVEMENT PERMIT w/ plan valid without expiration ☐ IMPROVEMENT PERMIT w / site plan valid for 60 mos. ☑ AUTHORIZATION TO CONSTRUCT valid for period equal to IMPROVEMENT PERMIT-not to exceed 60 mo.

Owner / Applicant Signature: Abby Helms Date 11/29/12

Improvement Permit by: Justin Henderson Date 11-27-12

Authorization to Construct by: Justin Henderson Date 11-27-12

Installed by: Tim ABEE

Operation Permit by: Date: 10-8-13

Existing System Inspected by: Date:

YOU SHOULD CONTACT A LOCATOR SERVICE PRIOR TO ANY EXCAVATION.

WHITE COPY Environmental Health YELLOW COPY (Final) Owner / Applicant PINK COPY (Initial) Owner / Applicant