4675291789   1:30

IREDELL COUNTY HEALTH DEPARTMENT

STATESVILLE 704-878-5305   MOORESVILLE 704-664-5281

IMPROVEMENT PERMIT / CERTIFICATE OF COMPLETION / OPERATION PERMIT / EXISTING SYSTEM INSPECTION

PROPERTY DESCRIPTION NO. 26362   DATE 4/14/97   TAX MAP NO. 4675190127   Watershed: ☐ Yes ☒ No

OWNER OR CONTRACTOR John N. Johnston   PHONE: Business ______   Home 663-2155

ADDRESS 1540 Coddle Creek Rd Mooresville, NC 28115

LOCATION 136S ~ 2.5 miles on (R) just past Willford Rd first brick with concrete driveway

SUBDIVISION ______ BLOCK / SECTION ______ LOT ______ LOT AREA ______ SITE CLASS. ______ DESIGN FLOW ______ L.T.A.R. ______

Septic Tank: 1000 Gallons; STB 794 Date 2-2-97

Pump Tank: ______ Gallons; PT ______ Date ______

Pump Make: ______ Model ______ Serial No. ______

Nitrification Field: No Fields 1 Square Feet 900 Linear Feet 300

No Lines 3 Trench Width 36" Max Trench Bottom Depth 36" Gravel Depth 12"

☒ New System ☐ Repair System Type: I (II) III, IV, V, VI

System Description: Dual Box Conventional

Repair System Description: None

Maintenance Agreement Required: ☐ Yes ☒ No

☐ Slab ☐ Crawl Space ☐ Basement w/plumbing ☐ Basement wo/plumbing

☐ House/Mod. Home ☒ Mobile Home ☐ Business ☐ Other ______


No. Bedrooms 2   No. Bathrooms 2   No. Employees ______

Water Supply: ☒ Individual ☐ Community ☐ Public

Comments:

Comments:

INITIAL SITE SKETCH

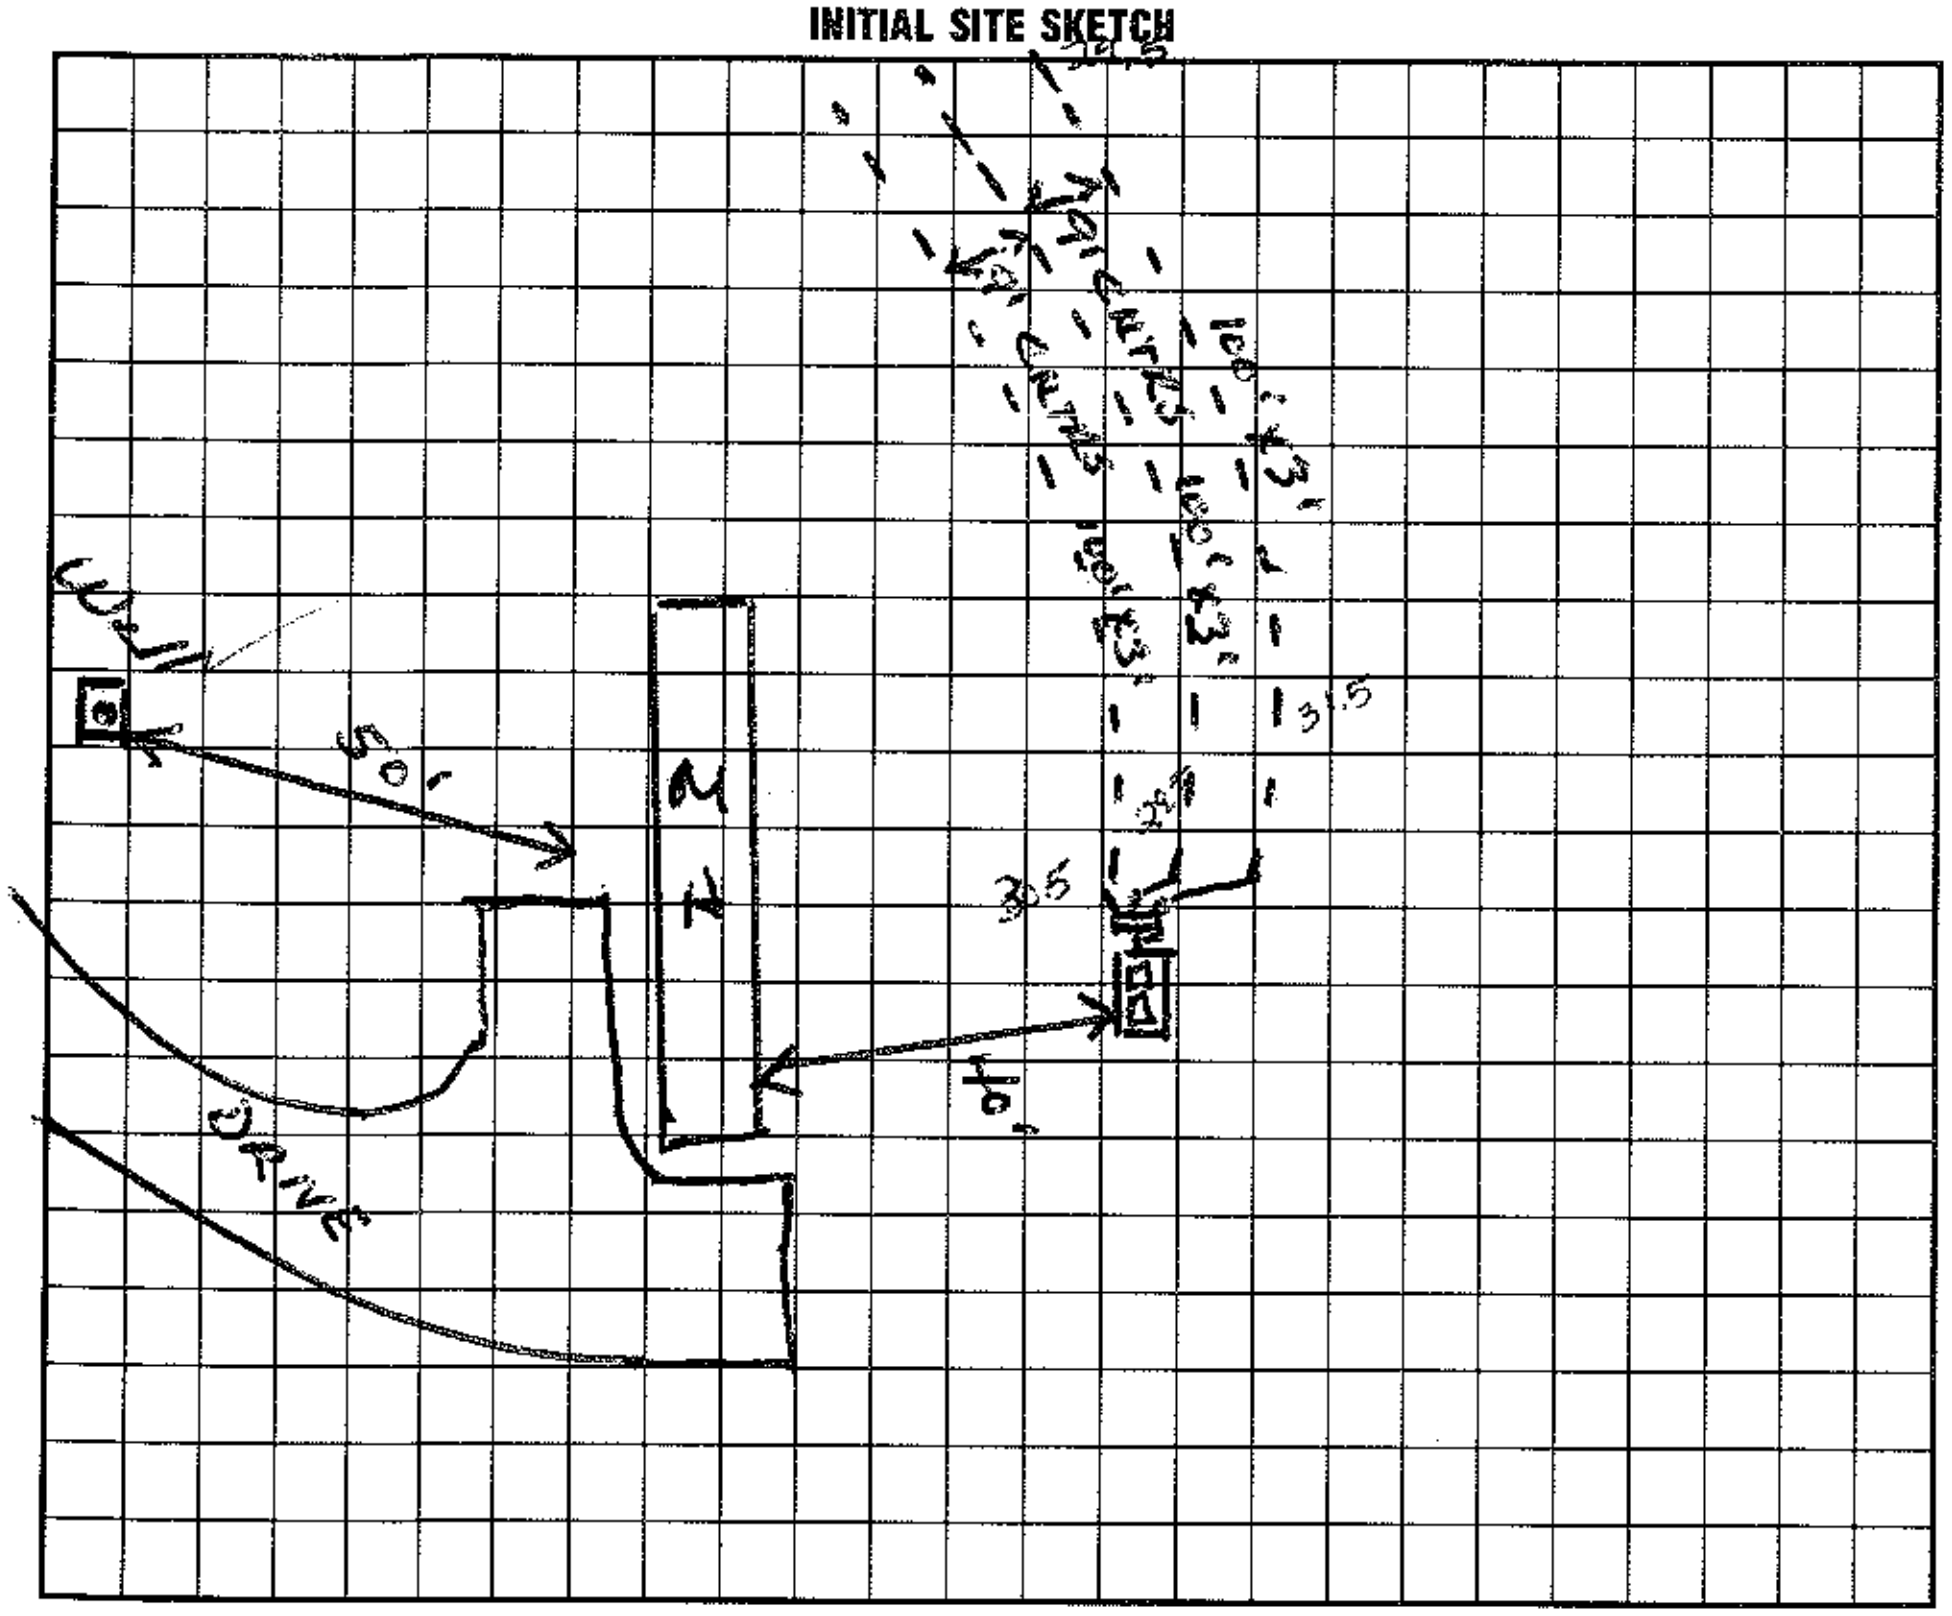

AS BUILT SKETCH

Installed as drawn.

I understand that this permit can be suspended or revoked if any false information is supplied toward securing the permit/any unauthorized changes are made to the site/any unauthorized changes are made in the installation of the system. Improvement Permit is valid for 60 months from date of issuance.

Signed: * [signature]

Improvement Permit by: Wesley Sparks RS. date 4/14/97

Existing System Inspection by: Wesley Sparks RS. date 4/14/97

Installed by: Julian Bowles

Certificate of Completion by: Maria Dotson date 5/2/97

Operation Permit by: Maria Dotson date 5/2/97

HEALTH DEPT. COPY: WHITE   INSPECTION COPY (FINAL): GREEN   OWNER COPY (FINAL): YELLOW   INSPECTION COPY (INITIAL): PINK   OWNER COPY (INITIAL): GOLD