IREDELL COUNTY HEALTH DEPARTMENT

STATESVILLE 704-878-5305 MOORESVILLE 704-664-5281

IMPROVEMENT PERMIT / CERTIFICATE OF COMPLETION / OPERATION PERMIT / EXISTING SYSTEM INSPECTION

PROPERTY DESCRIPTION NO. 25937 DATE 2/3/97 TAX MAP NO. 4675301241 (1B-H-12-B)

OWNER OR CONTRACTOR GARY + BARBARA WHITEHEAD PHONE: Business _____ Watershed: ☐ Yes ☐ No

ADDRESS 220 N. MAGNOLIA ST MOORESVILLE NC 28115 Home 662-0392

LOCATION CODDLE CREEK RD - DRIVE PAST HUNTER WOODS ON RT.

SUBDIVISION — BLOCK / SECTION — LOT — LOT AREA —

Septic Tank: EXISTING Gallons; STB _____ Date _____

Pump Tank: _____ Gallons; PT _____ Date _____

Pump Make: _____ Model _____ Serial No. _____

Nitrification Field: No Fields 1 Square Feet 600 Linear Feet 200

No Lines 2@100' Trench Width 36" Max Trench Bottom Depth — Gravel Depth 12"

SITE CLASS. PS DESIGN FLOW 240GPD L.T.A.R. .4 GPD/FT²

☑ New System ☐ Repair System Type: I (II) III, IV, V, VI

System Description: GRAVITY CONVENTIONAL

Repair System Description: SAME

Maintenance Agreement Required: ☐ Yes ☑ No

☐ House/Mod. Home No. Bedrooms 3

☑ Mobile Home No. Bathrooms 2

☐ Business No. Employees ____

☐ Other _____

☐ Slab ☑ Crawl Space ☐ Basement w/plumbing ☐ Basement wo/plumbing


Water Supply: ☑ Individual ☐ Community ☐ Public

Comments: WELL TO BE AT LEAST 50' FROM SEPTIC SYSTEM, 40' OFF OF PROPERTY SIDELINES. *

WELL NOT IN PLACE AT TIME OF EXISTING SYSTEM CHECK.

Comments:

INITIAL SITE SKETCH

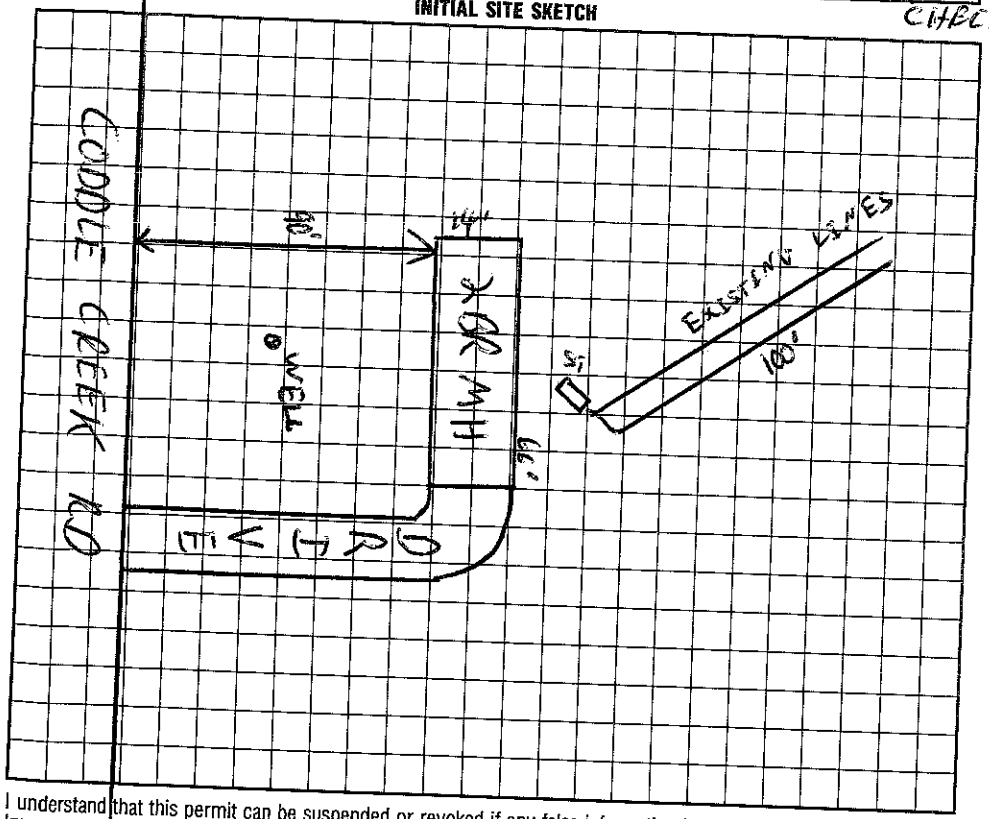

AS BUILT SKETCH

I understand that this permit can be suspended or revoked if any false information is supplied toward securing the permit/any unauthorized changes are made to the site/any unauthorized changes are made in the installation of the system. Improvement Permit is valid for 60 months from date of issuance.

Signed: Barbara Whitehead

Improvement Permit by: _____ date _____

Existing System Inspection by: C [signature] date 2/3/97

Installed by: _____

Certificate of Completion by: _____ date _____

Operation Permit by: C [signature] date 2/3/97

HEALTH DEPT. COPY: WHITE INSPECTION COPY (FINAL): GREEN OWNER COPY (FINAL): YELLOW INSPECTION COPY (INITIAL): PINK OWNER COPY (INITIAL): GOLD