IREDELL COUNTY HEALTH DEPARTMENT

STATESVILLE 704-878-5305 MOORESVILLE 704-664-5281

IMPROVEMENT PERMIT / AUTHORIZATION TO CONSTRUCT / OPERATION PERMIT / EXISTING SYSTEM INSPECTION

PERMIT# REPAIR PIN# 4675364598 DATE 2-14-07

OWNER OR APPLICANT Earnhardt Realty - Cindy Sims - mngr PHONE: Business _____ Home _____

ADDRESS _____

LOCATION Hwy 3 South (Coddle Crk Hwy), on right just past DEI facility, black gate at driveway

SUBDIVISION _____ BLOCK / SECTION _____ LOT _____ LOT AREA _____ SITE CLASS. _____ DESIGN FLOW 360gpd L.T.A.R. 1.3

Septic Tank: Existing Gallons: STB _____ Date _____

Pump Tank: _____ Gallons: PT _____ Date _____

Pump Make: _____ Model _____ Serial No. _____

Nitrification Field: No Fields 1 Square Feet 900 Linear Feet 300

No Lines 3@100' Trench Width 36" Max Trench Bottom Depth 36" Gravel Depth N/A

☐ New System ☒ Repair ☐ Expansion System Type: ☐ II ☒ III ☐ IV ☐ V ☐ VI

System Description: Gravity - 25% Reduction

Repair System Description: _____

Maintenance Agreement Required: ☐ Yes ☒ No

☒ House/Mod. Home No. Bedrooms 3

☐ Mobile Home No. Persons _____

☐ Business No. Employees _____

☐ Other _____


Water Supply: ☒ Individual ☐ Public ☐ Community — Existing

☐ Gravity ☐ Pressure ☐ Slab ☒ Crawl Space ☐ Basement w/plumbing ☐ Basement wo/plumbing

Comments:/Conditions:

1) USE existing ~~septic~~ septic tank, existing supply line 2) By-Pass old existing dist. box in route to new D-Box 3) Cross fence for new drainfield on contour AND install Ball Valve

INITIAL SITE SKETCH

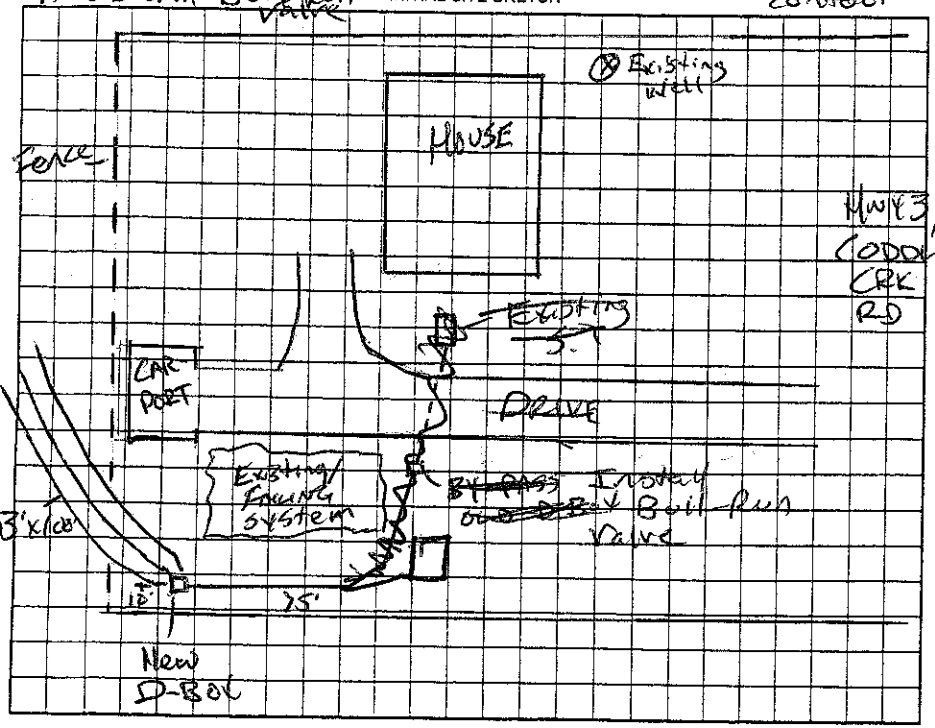

Comments:/Conditions:

4) IF existing supply line is not sleeved in approved material or approved depth under driveway, correct it during installation - possibly crushed due to vehicular traffic

AS BUILT SKETCH

Permit can be suspended or revoked if any false information is supplied toward securing the permit/any unauthorized changes are made to the site/any unauthorized changes are made in the installation of the system. Improvement Permit with plat valid without expiration ☐ Improvement Permit with site plan valid for sixty months ☒ Authorization to Construct is valid for a period equal to that of Improvement Permit – not to exceed sixty months.

Signed: Cindy Sims date 2.22.07 Installed by: _____

Improvement Permit by: _____ date _____ Operation Permit by: _____ date _____

Authorization to Construct by: Joseph E. Alph date 02-14-07 Existing System Inspection by: Joseph E. Alph date 2-14-07

HEALTH DEPT. COPY: WHITE OWNER COPY (FINAL): YELLOW OWNER COPY (INITIAL): PINK