IREDELL COUNTY HEALTH DEPARTMENT

STATESVILLE 704-878-5305 / 175.00 Paid MOORESVILLE 704-664-5281

IMPROVEMENT PERMIT / AUTHORIZATION TO CONSTRUCT / OPERATION PERMIT / EXISTING SYSTEM INSPECTION

PERMIT# 091562 PIN# 4675 36 5898 DATE 4/30/01

OWNER OR CONTRACTOR Dale Earnhardt Jr. PHONE: Business 662-8008 Home

ADDRESS 1720 Caddle Creek Rd. Mooresville, NC.

LOCATION 1365 on (R) across from DEI Complex

SUBDIVISION No BLOCK / SECTION LOT LOT AREA ~4.97 SITE CLASS. PS DESIGN FLOW 100 L.T.A.R. .3

Septic Tank: 1000 Gallons; STB 1012 Date 3/18/01

Pump Tank: Gallons; PT Date

Pump Make: Model Serial No.

Nitrification Field: No Fields 1 Square Feet 600 Linear Feet 200

No Lines 2 @ 100' Trench Width 3' Max Trench Bottom Depth 3' Gravel Depth 12"

[X] New System [ ] Repair System Type: I, [II] III, IV, V, VI

System Description: GRAVITY - CONVENTIONAL

Repair System Description: SAME

Maintenance Agreement Required: [ ] Yes [ ] No

[ ] House/Mod. Home No. Bedrooms

[ ] Mobile Home No. Bathrooms

[ ] Business No. Employees


[X] Other 1 BATH IN GARAGE

[ ] Slab [ ] Crawl Space [ ] Basement w/plumbing [ ] Basement wo/plumbing

Water Supply: [X] Individual [ ] Public [ ] Community


Comments:/Conditions:

INITIAL SITE SKETCH

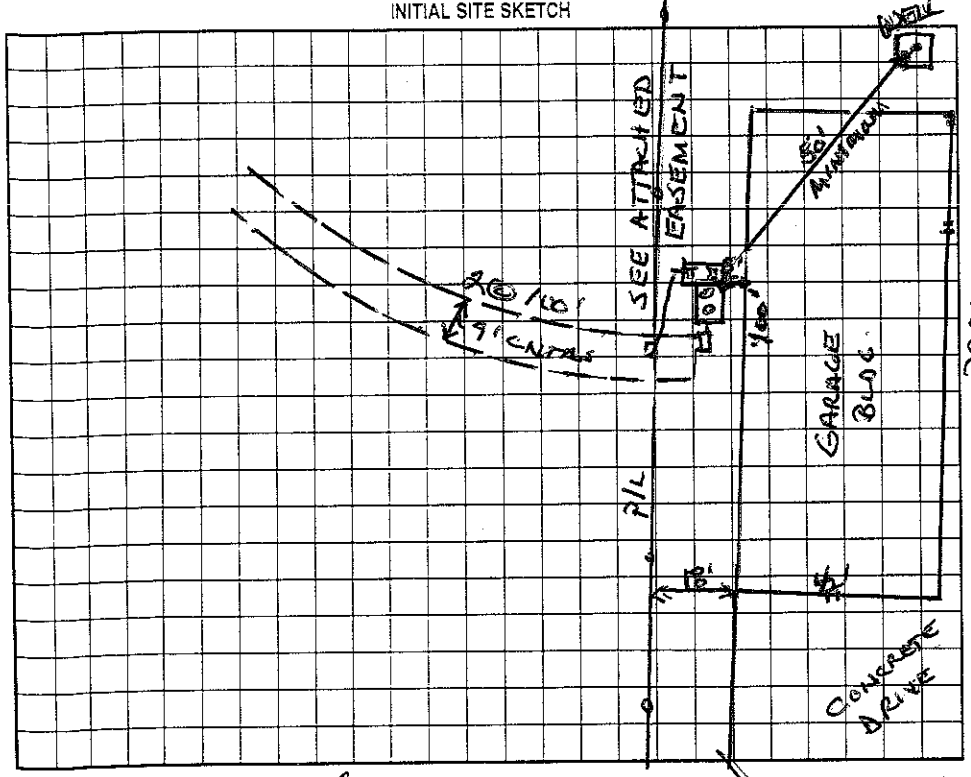

Comments:/Conditions:

AS BUILT SKETCH

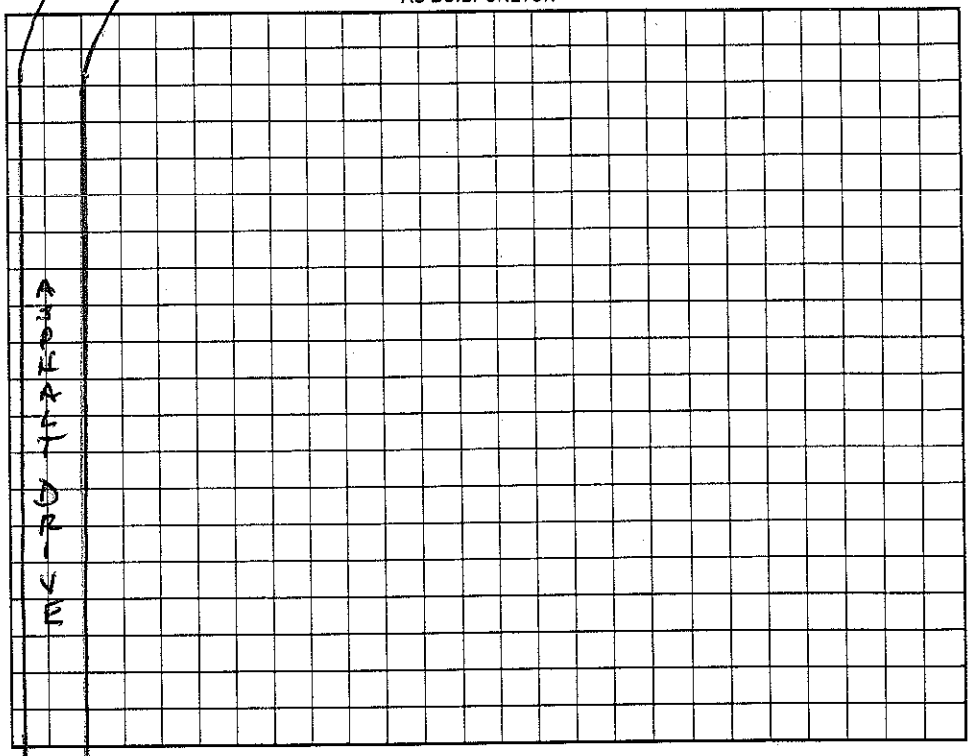

Permit can be suspended or revoked if any false information is supplied toward securing the permit/any unauthorized changes are made to the site/any unauthorized changes are made in the installation of the system. Improvement Permit with plat valid without expiration. Improvement Permit with site plan valid for sixty months. Authorization to Construct is valid for a period equal to that of Improvement Permit – not to exceed sixty months.

Signed: [signature] 5/3/2001 date Installed by: Steve Jordan

Improvement Permit by: Wesley Sparks RS. date 4/30/01 Operation Permit by: Wesley Sparks RS. date 5/30/01

Authorization to Construct by: Wesley Sparks RS date 4/30/01 Existing System Inspection by: date

HEALTH DEPT. COPY: WHITE OWNER COPY (FINAL): YELLOW OWNER COPY (INITIAL): PINK