# IREDELL COUNTY HEALTH DEPARTMENT

STATESVILLE 704-878-5305 MOORESVILLE 704-664-5281

## IMPROVEMENT PERMIT / AUTHORIZATION TO CONSTRUCT / OPERATION PERMIT / EXISTING SYSTEM INSPECTION

PERMIT# 083308 PIN# 4675 36 5898 DATE 8/19/99

OWNER OR CONTRACTOR Dale Earnhardt Jr. PHONE: Business 664-7888-BARRINGER Home

ADDRESS 1720 Caddle Creek Rd. Mooresville, NC. 28115

LOCATION 1365 on R just past DEI TR, TR house on R with pool in rear

SUBDIVISION No BLOCK SECTION LOT LOT AREA ~4.97AC SITE CLASS RS DESIGN FLOW 480 L.T.A.R. .25

Septic Tank: 1250 EX. Gallons; STB Date

Pump Tank: Gallons; PT Date

Pump Make: Model Serial No.

Nitrification Field: No Fields 1 Square Feet 1035 Linear Feet 345

No Lines 3 Trench Width 36" Max Trench Bottom Depth 36" Gravel Depth 12"

☐ New System ☒ Repair System Type: I, II, ☑ III, IV, V, VI

System Description: BULL RUN VALVE – CONVENTIONAL

Repair System Description: SAME

Maintenance Agreement Required: ☐ Yes ☒ No

☒ House/Mod. Home ☐ Mobile Home ☐ Business ☐ Other


No. Bedrooms 4 No. Bathrooms 3 No. Employees

☐ Slab ☐ Crawl Space ☒ Basement w/plumbing ☐ Basement wo/plumbing

Water Supply: ☒ Individual ☐ Public ☐ Community

Comments:/Conditions (1"=50')

INITIAL SITE SKETCH

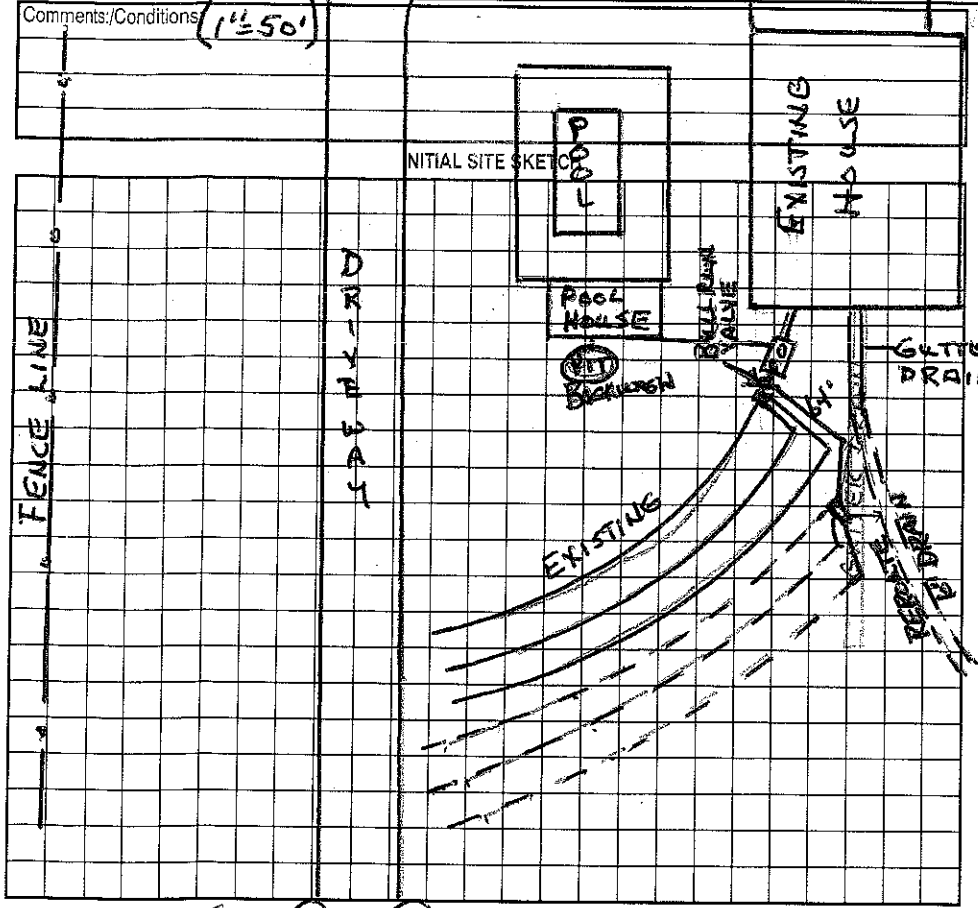


Comments:/Conditions: 1 = NEW FIELD - SET 10/28/99

2 = OLD FIELD

AS BUILT SKETCH

Permit can be suspended or revoked if any false information is supplied toward securing the permit/any unauthorized changes are made to the site/any unauthorized changes are made in the installation of the system. Improvement Permit with plat valid without expiration. Improvement Permit with site plan valid for sixty months. Authorization to Construct is valid for a period equal to that of Improvement Permit – not to exceed sixty months.

Signed: date 8/19/99

Improvement Permit by: Wesley Sparks R.S. date 8/19/99

Authorization to Construct by: Wesley Sparks R.S. date 8/19/99

Installed by: Steve Jordan

Operation Permit by: Wesley Sparks R.S. date 10/28/99

Existing System Inspection by: date

HEALTH DEPT. COPY: WHITE OWNER COPY (FINAL): YELLOW OWNER COPY (INITIAL): PINK