IREDELL COUNTY HEALTH DEPARTMENT

STATESVILLE 704-878-5305 MOORESVILLE 704-664-5281

IMPROVEMENT PERMIT / AUTHORIZATION TO CONSTRUCT / OPERATION PERMIT / EXISTING SYSTEM INSPECTION

PERMIT # _____ PIN # 4675 39 0165 DATE 11/10/09

OWNER or APPLICANT Joe Meade PHONE: Business _____ Home: 704-664-6909

OWNER or APPLICANT ADDRESS 124 Hunters Creek Dr. Mooresville, NC. 28115

LOCATION / DIRECTIONS Hwy 3 South TL Hunters Creek Dr. TR, 1st Drive on (R) #124

SUBDIVISION Hunters Creek BLOCK / SECTION _____ LOT # 2 LOT AREA ~, 94c DESIGN FLOW 360 L.T.A.R. _____

Septic Tank EXISTING Gallons: STB _____ Date _____

Pump Tank _____ Gallons: P T _____ Date _____

Pump Make _____ Model _____ Serial # _____

Nitrification Field No Fields 1 No Lines EXISTING Linear Feet _____

Trench Width _____ Max. Trench Bottom Depth _____ Gravel Depth _____

☐ New System ☐ Repair ☐ Expansion System Type I II III IV V VI

System Description: GR - CONVENTIONAL

Repair System Description: _____

Maintenance Agreement Required ☐ YES ☒ NO

☒ GRAVITY ☐ PRESSURE

☒ Residence No. Bedrooms 3

☐ Business No. Persons _____

☐ Other No. Employees _____

☐ Slab ☒ Crawl Space


☐ Basement w/plumbing ☐ Basement w/o plumbing

Water Supply: ☒ Private ☐ Public ☐ Community


Comments / Conditions

Comments / Conditions

INITIAL SITE SKETCH

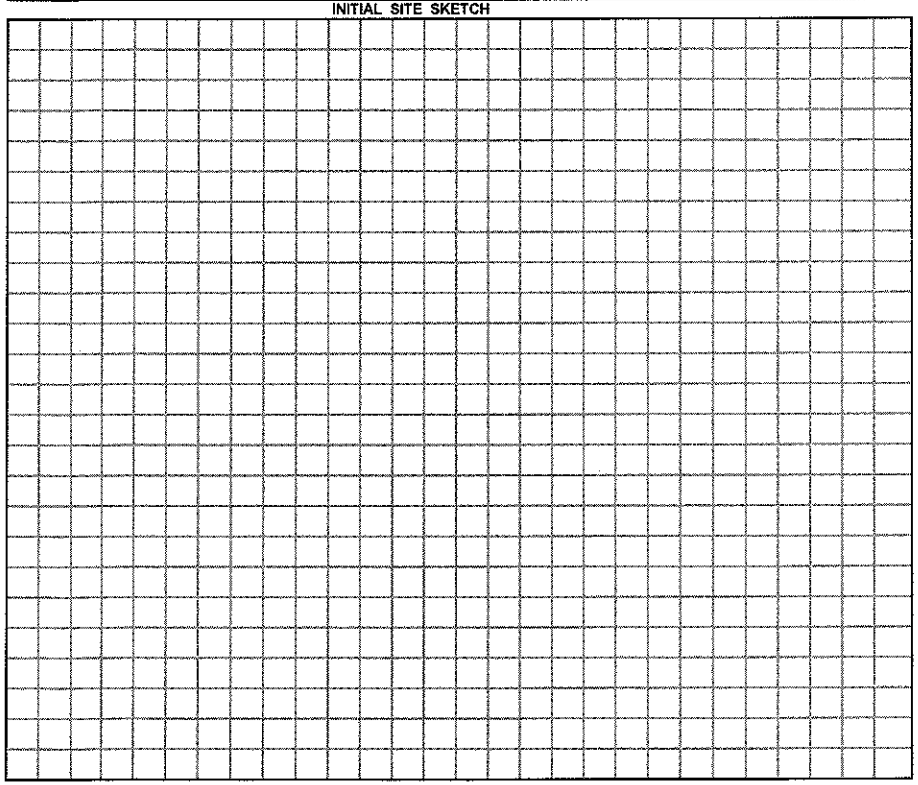

AS BUILT SKETCH

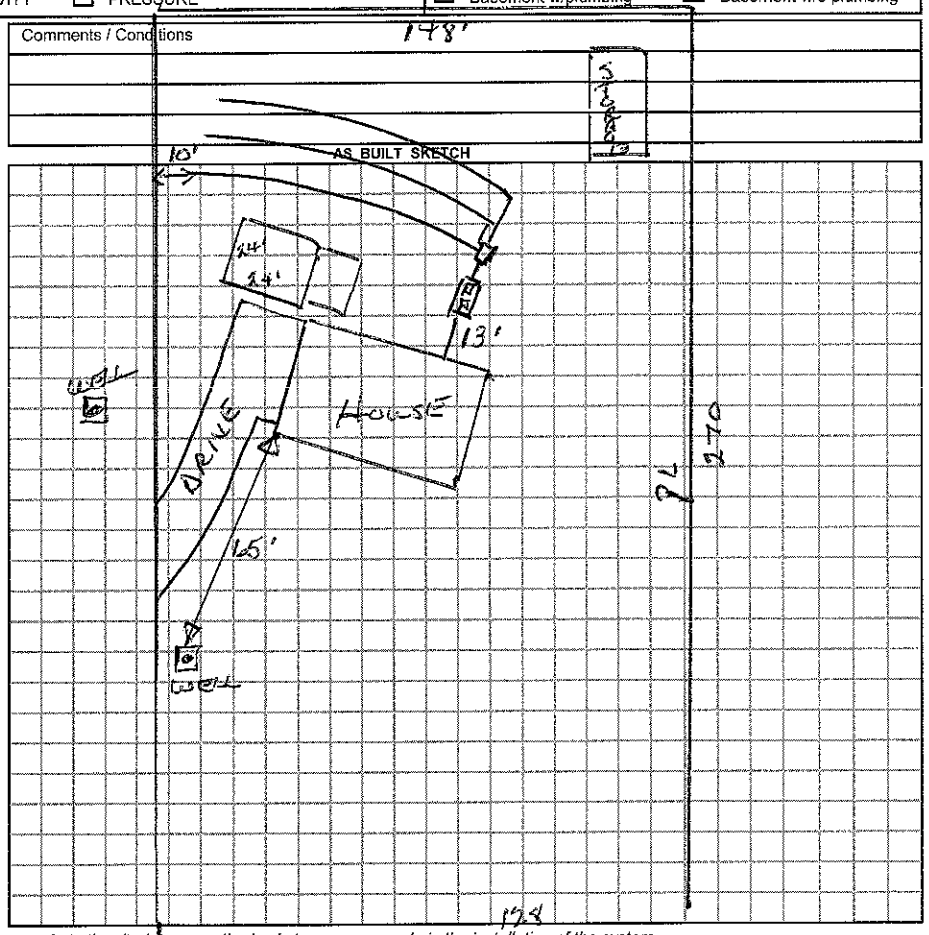

Permit can be suspended or revoked if any false information is supplied toward securing the permit / any unauthorized changes are made to the site / any unauthorized changes are made in the installation of the system

☐ *IMPROVEMENT PERMIT w / plat valid without expiration* ☐ *IMPROVEMENT PERMIT w / site plan valid for 60 mos.* ☐ *AUTHORIZATION TO CONSTRUCT valid for period equal to IMPROVEMENT PERMIT-not to exceed 60 mo.*

Owner / Applicant Signature: _____ Date 11/12/09

Improvement Permit by: _____ Date _____

Authorization to Construct by: _____ Date _____

YOU SHOULD CONTACT A LOCATOR SERVICE PRIOR TO ANY EXCAVATION.


Operation Permit by: _____ Date: _____

Existing System Inspected by: Wesley Sparks RS. Date: 11/10/09

WHITE COPY Environmental Health YELLOW COPY (Final) Owner / Applicant PINK COPY (Initial) Owner / Applicant