(11:00)

IREDELL COUNTY HEALTH DEPARTMENT

STATESVILLE 704-878-5305 MOORESVILLE 704-664-5281

IMPROVEMENT PERMIT / AUTHORIZATION TO CONSTRUCT / OPERATION PERMIT / EXISTING SYSTEM INSPECTION

PERMIT# 80948 PIN# 4675-39-6119 DATE 5/14/99

OWNER OR CONTRACTOR THOMAS KISTLER PHONE: Business _____ Home _____

ADDRESS 1635 LOOKOUT CREEK RD - MOORESVILLE NC 28115

LOCATION 1365 - ACROSS FROM ROCK 4 RIVER RD

SUBDIVISION _____ BLOCK / SECTION _____ LOT _____ LOT AREA 14.67Ac SITE CLASS. PS DESIGN FLOW 240 L.T.A.R. .3

Septic Tank: 1000 Gallons; STB 1012 Date 4-13-99
Pump Tank: _____ Gallons; PT _____ Date _____
Pump Make: _____ Model _____ Serial No. _____
Nitrification Field: No Fields 1 Square Feet @ 600 Linear Feet 200
No Lines 2@100 Trench Width 36" Max Trench Bottom Depth 36" Gravel Depth _____

☒ New System ☐ Repair System Type: I, II, (III), IV, V, VI
System Description: GRAVITY EZLAY OR CHAMBERS
Repair System Description: SAME
Maintenance Agreement Required: ☐ Yes ☒ No

☒ House/Mod. Home No. Bedrooms 2
☐ Mobile Home No. Bathrooms 2
☐ Business No. Employees _____
☐ Other _____


☐ Slab ☒ Crawl Space ☐ Basement w/plumbing ☐ Basement wo/plumbing

Water Supply:
☒ Individual
☐ Public
☐ Community

Comments:/Conditions:

Comments:/Conditions:

INITIAL SITE SKETCH

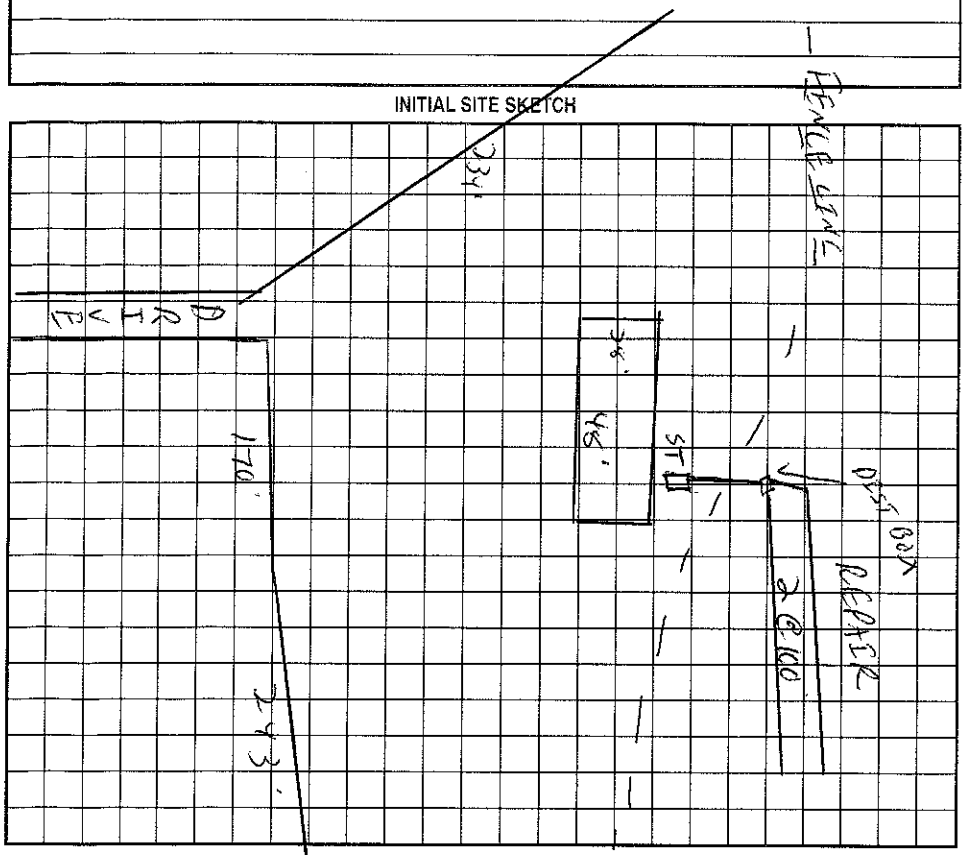

AS BUILT SKETCH

Permit can be suspended or revoked if any false information is supplied toward securing the permit/any unauthorized changes are made to the site/any unauthorized changes are made in the installation of the system. Improvement Permit with plat valid without expiration. Improvement Permit with site plan valid for sixty months. Authorization to Construct is valid for a period equal to that of Improvement Permit – not to exceed sixty months.

Signed: Thomas L. Kistler date 5-18-99 Installed by: A-1 Backhoe

Improvement Permit by: C. [illegible] KS date 5/14/99 Operation Permit by: John Myers date 6-4-99

Authorization to Construct by: C. [illegible] KS date 5/14/99 Existing System Inspection by: _____ date _____

HEALTH DEPT. COPY: WHITE OWNER COPY (FINAL): YELLOW OWNER COPY (INITIAL): PINK