IREDELL COUNTY HEALTH DEPARTMENT

Author onto Constant 3:30

SVILLE 704-878-5305 MOORESVILLE 704-664-5281

IMPROVEMENT PERMIT / ~~CERTIFICATE OF COMPLETION~~ / OPERATION PERMIT / EXISTING SYSTEM INSPECTION

PROPERTY DESCRIPTION NO. REPAIR DATE 4/5/97 TAX MAP NO. N/A Watershed: [X] Yes [ ] No

OWNER OR CONTRACTOR Dale Earnhardt Inc. PHONE: Business 664-7888 Home

ADDRESS 1675 Coddle Creek Rd. Mooresville, NC 28115 PIN# 4675-47-0150

LOCATION 1365 TL just before Temple Rd. Lean (L) to MH on (L)

SUBDIVISION No BLOCK / SECTION LOT LOT AREA SITE CLASS. DESIGN FLOW 360 L.T.A.R. .25

Septic Tank: Existing Gallons; STB Date

Pump Tank: Gallons; PT Date

Pump Make: Model Serial No.

Nitrification Field: No Fields 1 Square Feet 765 Linear Feet 250

No Lines 2 Trench Width 36" Max Trench Bottom Depth 36" Gravel Depth

[ ] New System [X] Repair System Type: I, II, III, IV, V, VI

System Description: DIST BOX - CONVENTIONAL

Repair System Description:

Maintenance Agreement Required: [ ] Yes [X] No

[ ] House/Mod. Home No. Bedrooms 3

[X] Mobile Home No. Bathrooms 2


[ ] Business No. Employees

[ ] Other

[ ] Slab [ ] Crawl Space [ ] Basement w/plumbing [ ] Basement wo/plumbing

Water Supply: [X] Individual [ ] Community [ ] Public

Comments: FENCE LINE

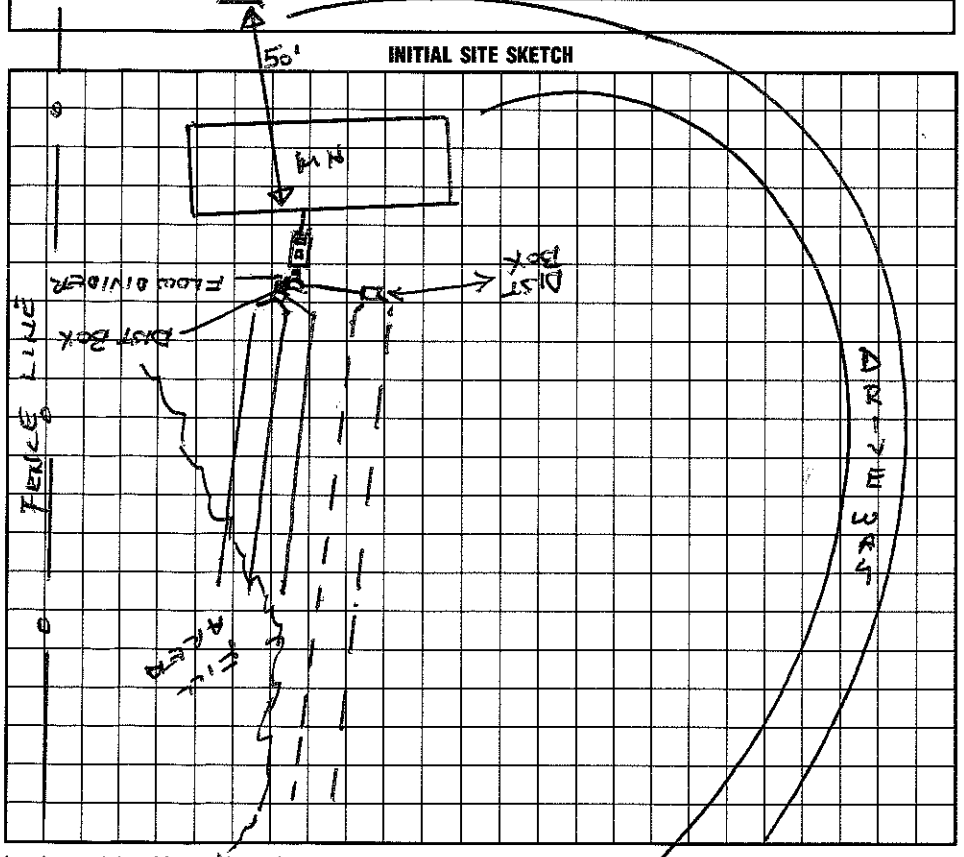

Comments: V = 1,170 + 500

250 720 GPD 1342 GAL TANKAGE

345 ÷ .25 = 2880 1000

595 - SR16 SYSTEM 960 FT. (+415) 360 ÷ .25 = 1440

AS BUILT SKETCH 4 @ 120' x 3'

SAME AS SITE SKETCH

I understand that this permit can be suspended or revoked if any false information is supplied toward securing the permit/any unauthorized changes are made to the site/any unauthorized changes are made in the installation of the system. Improvement Permit is valid for 60 months from date of issuance.

Signed: X Cliff Cook (DET)

Improvement Permit by: Wesley Sparks R.S. date 8/5/97

Existing System Inspection by: Wesley Sparks R.S. date 8/5/97

Installed by: ROWAN SEPTIC

Certificate of Completion by: date

Operation Permit by: C. [illegible] date 9/3/97

HEALTH DEPT. COPY: WHITE INSPECTION COPY (FINAL): GREEN OWNER COPY (FINAL): YELLOW INSPECTION COPY (INITIAL): PINK OWNER COPY (INITIAL): GOLD