4675551639

IREDELL COUNTY HEALTH DEPARTMENT

STATESVILLE 704-878-5305 MOORESVILLE 704-664-5281

IMPROVEMENT PERMIT / CERTIFICATE OF COMPLETION / OPERATION PERMIT / EXISTING SYSTEM INSPECTION

PROPERTY DESCRIPTION NO. Repair DATE 3/15/96 TAX MAP NO. Watershed: ☐ Yes ☑ No

OWNER OR CONTRACTOR Jimmy Howard PHONE: Business Home 664-6103

ADDRESS 156 Sample Rd Mooresville 28115

LOCATION 136 S JL Sample Rd - First House on Right

SUBDIVISION — BLOCK / SECTION — LOT — LOT AREA SITE CLASS PS DESIGN FLOW 360gpd TAR .3gpd/ft²

Septic Tank: 1000 Gallons; STB existing Date existing

Pump Tank: Gallons; PT Date

Pump Make: Model Serial No.

Nitrification Field: No Fields 1 Square Feet 900 Linear Feet 300

No Lines 4 Trench Width 36" Max Trench Bottom Depth 36" Gravel Depth N/A

☐ New System ☑ Repair System Type: I. II. III. IV. V. VI

System Description: Gravity Chambered

Repair System Description:

Maintenance Agreement Required: ☐ Yes ☑ No

☑ House/Mod. Home No. Bedrooms 3

☐ Mobile Home No. Bathrooms 2

☐ Business No. Employees

☐ Other


Water Supply: ☑ Individual ☐ Community ☐ Public

☐ Slab ☑ Crawl Space ☐ Basement w/plumbing ☐ Basement wo/plumbing


Comments: No Record of old system was found.

Comments:

INITIAL SITE SKETCH

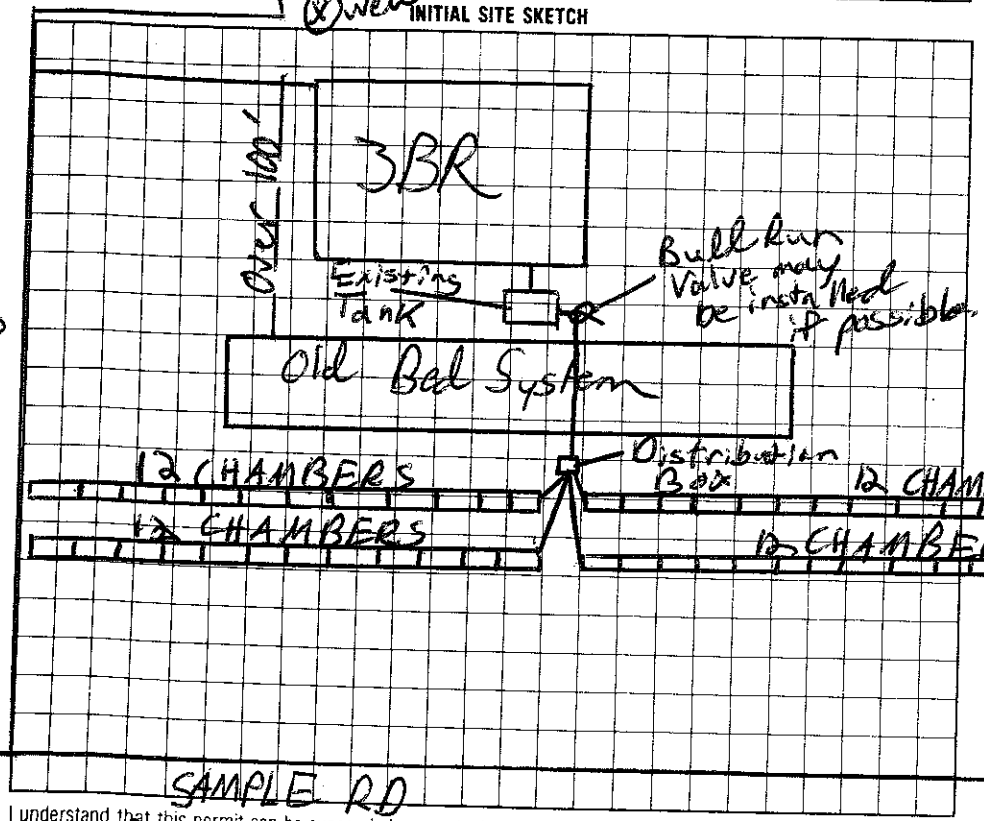

AS BUILT SKETCH

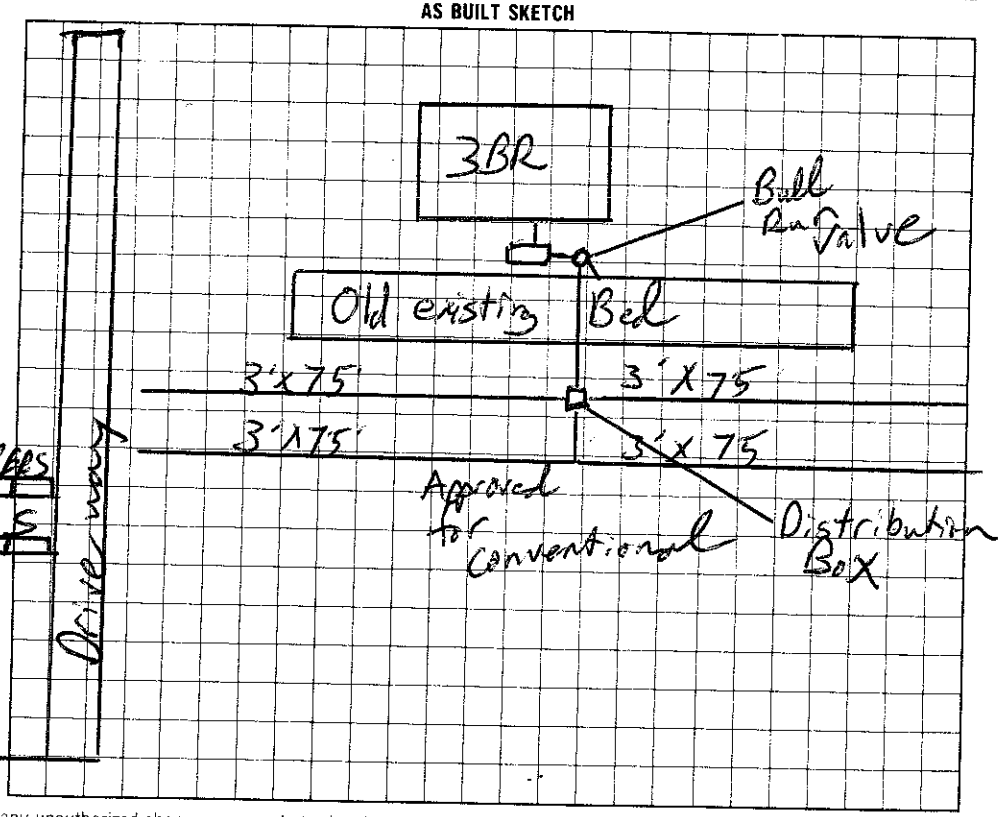

I understand that this permit can be suspended or revoked if any false information is supplied toward securing the permit/any unauthorized changes are made to the site/any unauthorized changes are made in the installation of the system.

Signed: X Jimmy Howard

Improvement Permit by: C. Rusty Teem EHSI date 3/15/96

~~Existing System Inspection by:~~ C. Rusty Teem EHSI date 3/15/96

Installed by: Rusty Orbison

Certificate of Completion by: C. Rusty Teem EHSI date ~~3/15/96~~ 3/21/96

Operation Permit by: date

HEALTH DEPT. COPY: WHITE INSPECTION COPY (FINAL): GREEN OWNER COPY (FINAL): YELLOW INSPECTION COPY (INITIAL): PINK OWNER COPY (INITIAL): GOLD