IREDELL COUNTY HEALTH DEPARTMENT

Statesville Office (704) 878-5305 Mooresville Office (704) 660-3625 PERMIT # 203918

IMPROVEMENT PERMIT / AUTHORIZATION TO CONSTRUCT / OPERATION PERMIT / EXISTING SYSTEM

PIN # 4675810658.000

APPLICANT: Daniel Hill APPLICANT ADDRESS: 20213 Wave Ct. Cornelius, NC 28031

SITE ADDRESS: 175 Powers Hill Rd. Mooresville NC PHONE: 919-538-3111 ALT. PHONE: —

SITE DIRECTIONS: NC 3 S, To Patterson Farm Rd., To Powers Hill Rd.

SUBDIVISION: — SECTION: — LOT # — LOT AREA: 15.690 Acres DESIGN FLOW: 240 GPD L.T.A.R.: —

Septic Tank Existing (gal) STB Date
Pump Tank (gal) PT Date
Pump Make Model Serial #
Nitrification Fields 1 # Lines 3 Linear Ft: 260
Trench Width 36" Max. Trench Bottom Depth Existing Gravel Depth Existing


☐ New System ☐ Repair ☐ Expansion System Type: I II III IV V VI
System Description: Existing Gravel (Gravity)
Repair System Description:
Maintenance Agreement Required: ☐ YES ☐ NO
☐ GRAVITY ☐ PRESSURE

☐ Residence No. Bedrooms 2
☐ Business No. Persons 4
☐ Other No. Employees
☐ Slab ☐ Crawl Space
☐ Basement w/plumbing ☐ Basement w/o plumbing

Water Supply
☑ Private
☐ Public
☐ Community


Comments / Conditions:

INITIAL SITE SKETCH

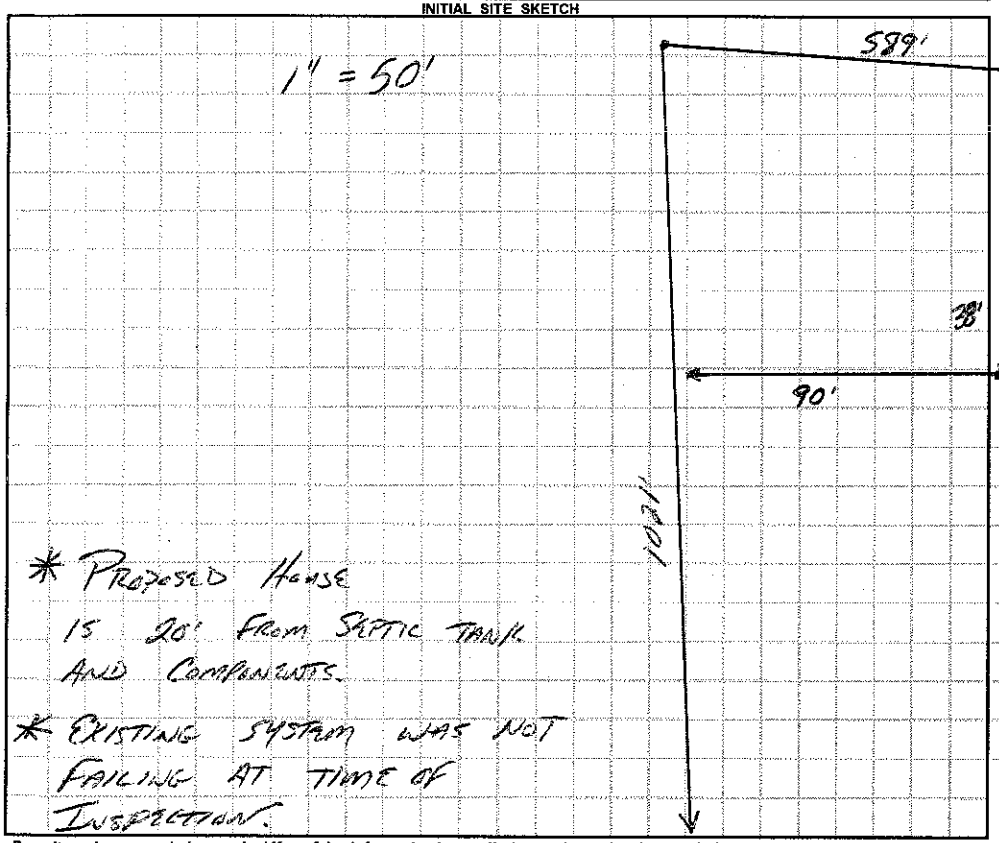

* Proposed House is 20' from Septic Tank and Components.
* Existing System was not failing at time of Inspection.

AS BUILT SKETCH

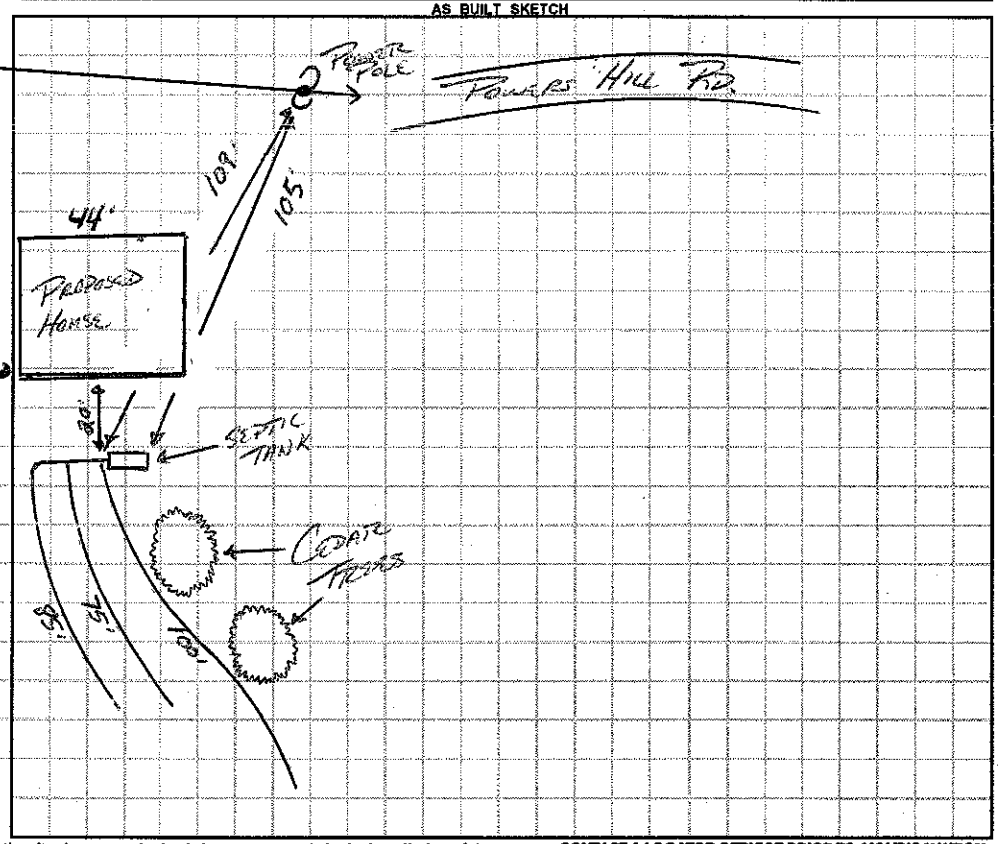

Permit can be suspended or revoked if any false information is supplied toward securing the permit / any unauthorized changes are made to the site / any unauthorized changes are made in the installation of the system. **CONTACT A LOCATOR SERVICE PRIOR TO ANY EXCAVATION**

☐ **IMPROVEMENT PERMIT** *with plat valid without expiration.* ☐ **IMPROVEMENT PERMIT** *with site plan valid for 60 mos.* ☐ **AUTHORIZATION TO CONSTRUCT** *valid for period equal to IMPROVEMENT PERMIT--not to exceed 60 mo.*

Owner / Applicant Signature: Date: Installed by:

IMPROVEMENT PERMIT by: Date: OPERATION PERMIT by: Date:

AUTHORIZATION TO CONSTRUCT by: Date: Existing System Inspected by: Date: 8/11/14

Health Dept. Copy - WHITE Applicant (Final Approval) - YELLOW Applicant (Conditional Approval) - PINK