IREDELL COUNTY HEALTH DEPARTMENT

STATESVILLE 704-878-5305 MOORESVILLE 704-664-5281

IMPROVEMENT PERMIT / AUTHORIZATION TO CONSTRUCT / OPERATION PERMIT / EXISTING SYSTEM INSPECTION

PERMIT# 101487 PIN# 4675841673 DATE 7/27/01

OWNER OR CONTRACTOR MICHAEL JOHNSTON PHONE: Business 528-0358 Home

ADDRESS 339 HEMLOCK RD CLEVELAND (BROWN)

LOCATION HWY 136(S) - TL SAMPLE RD - AT VERY END

SUBDIVISION N/A BLOCK / SECTION LOT N/A LOT AREA ~6 AC SITE CLASS. PS DESIGN FLOW 360GPD L.T.A.R. .36GPD/FT²

Septic Tank: 1000 Gallons; STB 825 Date 6/20/00

Pump Tank: Gallons; PT Date

Pump Make: Model Serial No.

Nitrification Field: No Fields 1 Square Feet 1200 Linear Feet 400

No Lines 4@100' Trench Width 36" Max Trench Bottom Depth 36" Gravel Depth 12"

☑ New System ☐ Repair System Type: I (II) III, IV, V, VI

System Description: GRAVITY CONVENTIONAL

Repair System Description: SAME

Maintenance Agreement Required: ☐ Yes ☑ No

☐ House/Mod. Home No. Bedrooms 3

☐ Mobile Home No. Bathrooms 3

☐ Business No. Employees

☐ Other

☐ Slab ☑ Crawl Space ☐ Basement w/plumbing ☐ Basement wo/plumbing


Water Supply: ☐ Individual ☐ Public ☐ Community

Comments:/Conditions:


Comments:/Conditions:

WELL FROM NEIGHBOR

INITIAL SITE SKETCH NOT TO SCALE

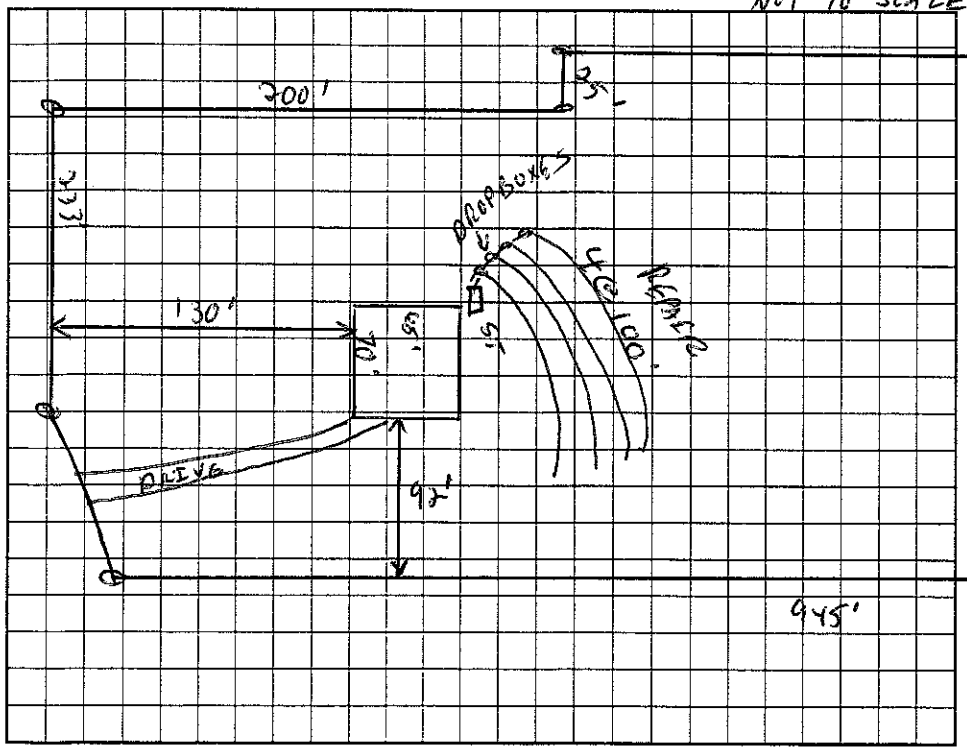

AS BUILT SKETCH

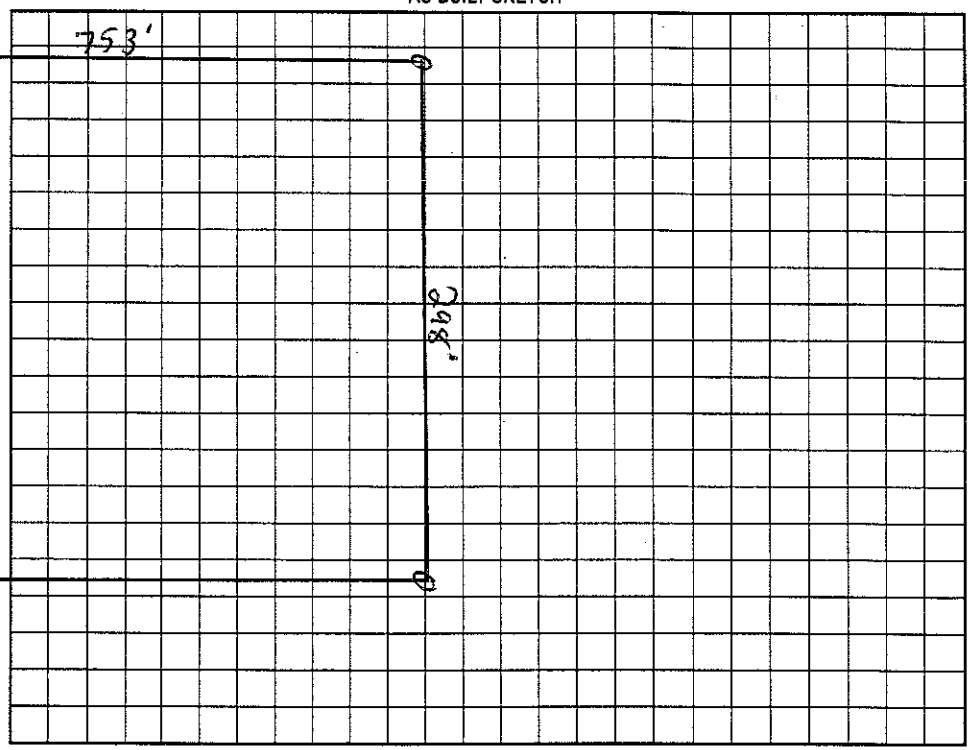

Permit can be suspended or revoked if any false information is supplied toward securing the permit/any unauthorized changes are made to the site/any unauthorized changes are made in the installation of the system. Improvement Permit with plat valid without expiration. Improvement Permit with site plan valid for sixty months. Authorization to Construct is valid for a period equal to that of Improvement Permit – not to exceed sixty months.

Signed: date

Improvement Permit by: RS date 7/27/01

Authorization to Construct by: RS date 7/27/01

Installed by: Upright Grading & Septic Co.

Operation Permit by: date 10/11/01

Existing System Inspection by: date

HEALTH DEPT. COPY: WHITE OWNER COPY (FINAL): YELLOW OWNER COPY (INITIAL): PINK