R EDELL COUNTY HEALTH DEPARTMENT

STATESVILLE 704-878-5305 MOORESVILLE 704-664-5281

200

M PROVEMENT PERMIT / AUTHORIZATION TO CONSTRUCT / OPERATION PERMIT / EXISTING SYSTEM INSPECTION

RMIT# 093271 PIN# 4676 00 3776 / 4676 07270 DATE 12/5/00

WNER OR CONTRACTOR Mabel Johnston PHONE: Business Home 664-1812

DDRESS 1540 Caddle Creek Rd. Mooresville, NC. 28117

OCATION 1365 on (R) just past Wilford Rd ~ 800' from road R/W

UBDIVISION N/A BLOCK / SECTION LOT LOT AREA 173.22 SITE CLASS. PS DESIGN FLOW 360 L.T.A.R. .3

Septic Tank: 1000 Gallons; STB 794 Date 4/23/01

Pump Tank: Gallons; PT Date

Pump Make: Model Serial No.

Verification Field: No Fields 1 Square Feet 1200 Linear Feet 460

of Lines 4 Trench Width 3' Max Trench Bottom Depth 3' Gravel Depth 12"

[X] New System [ ] Repair System Type: I (II) III, IV, V, VI

System Description: Gravity Conventional

Repair System Description: Same

Maintenance Agreement Required: [ ] Yes [X] No

[X] House/Mod. Home No. Bedrooms 3

[ ] Mobile Home No. Bathrooms 3

[ ] Business No. Employees

[ ] Other

[ ] Slab [ ] Crawl Space [X] Basement w/plumbing [X] Basement wo/plumbing


Water Supply: [X] Individual [ ] Public [ ] Community

Comments:/Conditions:

Repair Area

Comments:/Conditions:

INITIAL SITE SKETCH

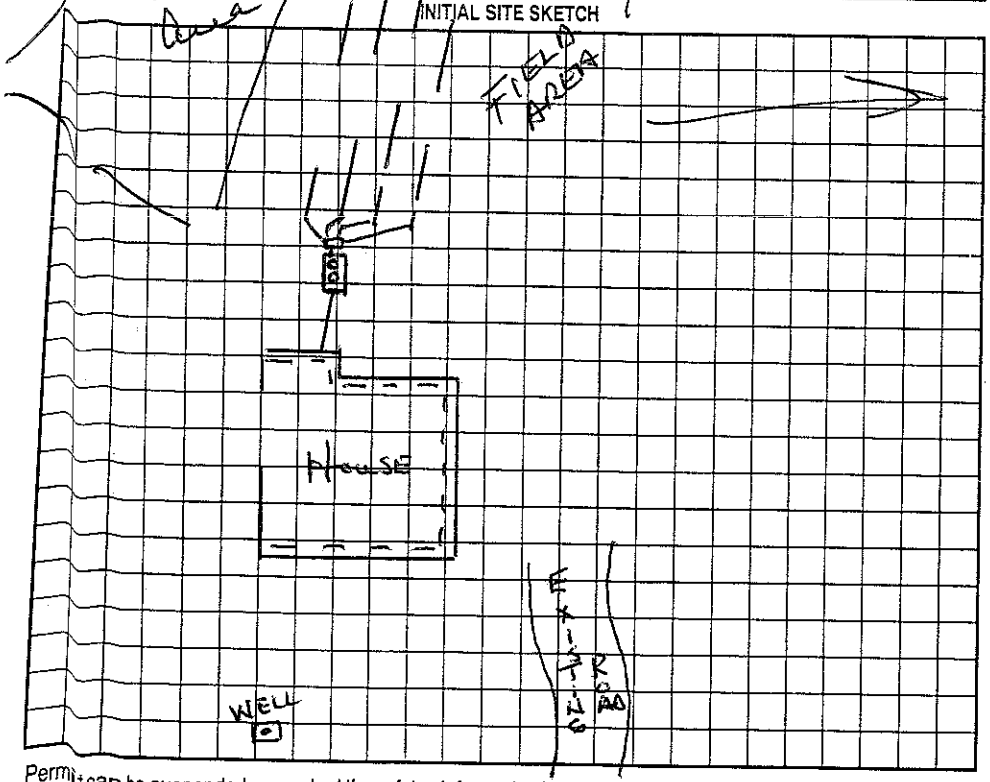

AS BUILT SKETCH

Permit can be suspended or revoked if any false information is supplied toward securing the permit/any unauthorized changes are made to the site/any unauthorized changes are made in the installation of the system. Improvement Permit with plat valid without expiration. Improvement Permit with site plan valid for sixty months. Authorization to Construct is valid for a period equal to that of Improvement Permit – not to exceed sixty months.

Signed: * Wesley Woodfield date

Improvement Permit by: Wesley Sparks RS. date 12/5/00

Authorization to Construct by: Wesley Sparks RS. date 12/5/00

Installed by: Larry Beam

Operation Permit by: [signature] LSS date 6/15/01

Existing System Inspection by: date

HEALTH DEPT. COPY: WHITE OWNER COPY (FINAL): YELLOW OWNER COPY (INITIAL): PINK