IREDELL COUNTY HEALTH DEPARTMENT

STATESVILLE 704-878-5305 MOORESVILLE 704-664-5281

1000 300

IMPROVEMENT PERMIT / AUTHORIZATION TO CONSTRUCT / OPERATION PERMIT / EXISTING SYSTEM INSPECTION

PERMIT# 087633 PIN# 4676 11 7652 PIN# 4676-11-7653 DATE 3/15/00

OWNER OR CONTRACTOR Jennifer Greene PHONE: Business Home 528-0359

ADDRESS 4575 Mount St. Troutmen, NC. 28166

LOCATION 1365 TL Burley Dr. on (L) at culdesac

SUBDIVISION Burl Acres BLOCK / SECTION LOT 4 LOT AREA ~1.1 Ac SITE CLASS PS DESIGN FLOW 360 L.T.A.R. .3

Septic Tank: 1000 Gallons; STB 312 Date 11/5/00
Pump Tank: Gallons; PT Date
Pump Make: Model Serial No.
Nitrification Field: No Fields 1 Square Feet 1200 Linear Feet 400
No Lines 4 Trench Width 36" Max Trench Bottom Depth 36" Gravel Depth 12"

[X] New System [ ] Repair System Type: I, (II), III, IV, V, VI
System Description: Gravity Conventional
Repair System Description: Type 3 Drainfield
Maintenance Agreement Required: [ ] Yes [X] No

[X] House/Mod. Home [ ] Mobile Home [ ] Business [ ] Other
No. Bedrooms 3 No. Bathrooms 3 No. Employees


[ ] Slab [ ] Crawl Space [X] Basement w/plumbing [ ] Basement wo/plumbing

Water Supply: [X] Individual [ ] Public [ ] Community

Comments:/Conditions:

Comments:/Conditions: HOUSE MOVED SLIGHTLY TO RIGHT.

(1"=60') INITIAL SITE SKETCH

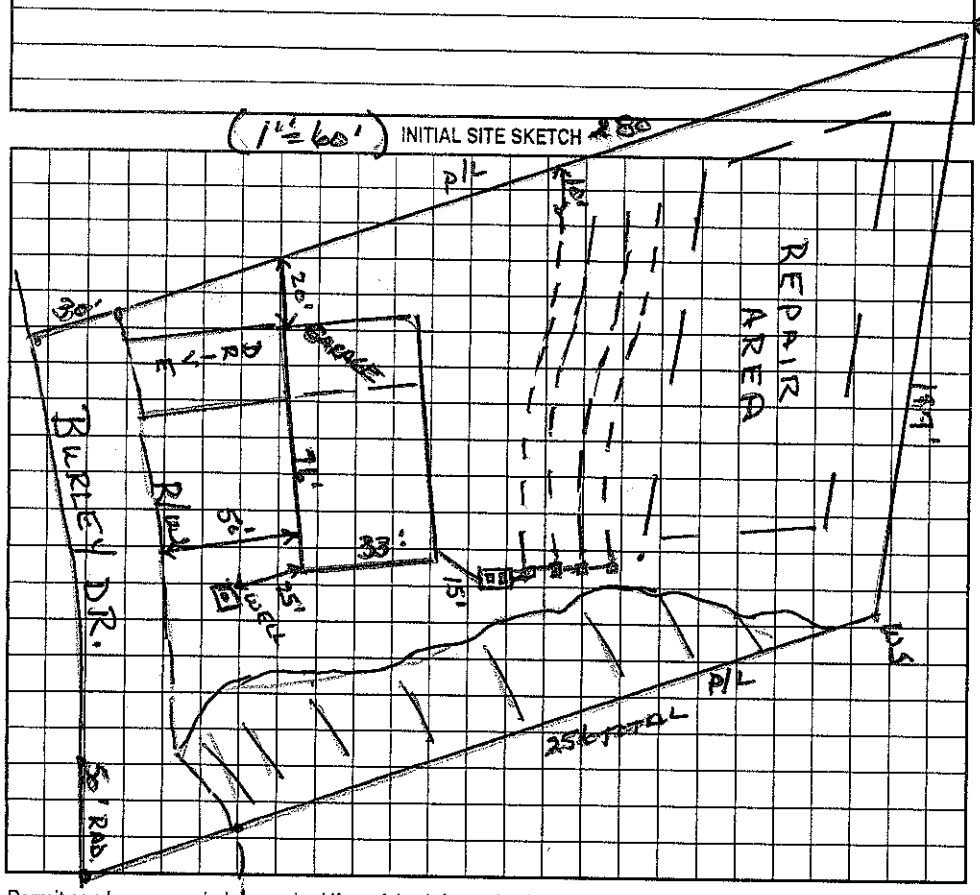

AS BUILT SKETCH

Permit can be suspended or revoked if any false information is supplied toward securing the permit/any unauthorized changes are made to the site/any unauthorized changes are made in the installation of the system. Improvement Permit with plat valid without expiration. Improvement Permit with site plan valid for sixty months. Authorization to Construct is valid for a period equal to that of Improvement Permit – not to exceed sixty months.

Signed: [signature] date

Improvement Permit by: Wesley Sparks RS. date 3/15/00

Authorization to Construct by: Wesley Sparks RS. date 3/15/00

Installed by: LARRY BEAM

Operation Permit by: [signature] RS date 1/16/01

Existing System Inspection by: date

HEALTH DEPT. COPY: WHITE OWNER COPY (FINAL): YELLOW OWNER COPY (INITIAL): PINK