IREDELL COUNTY HEALTH DEPARTMENT

STATESVILLE 704-878-5305 MOORESVILLE 704-664-5281

IMPROVEMENT PERMIT / CERTIFICATE OF COMPLETION / OPERATION PERMIT / EXISTING SYSTEM INSPECTION

PROPERTY DESCRIPTION NO. N/A DATE 6/14/93 TAX MAP NO. N/A

OWNER OR CONTRACTOR IREDELL MILK TRANS INC. PHONE: Business 664-3417 Home 4676 16 1585

ADDRESS Linwood Enochville Rd. Mooresville, NC. 28115

LOCATION Enochville Rd, 150 E TR on (R) just past Brumley Rd intersection

SUBDIVISION BLOCK / SECTION LOT LOT AREA SITE CLASS. P L.T.A.R. .25 - .3

Water Supply: ☑ Individual ☐ Community ☐ Public 2 WELLS

Septic Tank: 1000 Gallons; STB Date

Pump Tank: 1000 Gallons; PT 103 Date 4-19-93

Nitrification Field: No Fields 2 Square Feet 2083 Linear Feet 695

No Lines 6 Trench Width 3' Trench Depth 36" Gravel Depth 12"

☐ New System ☑ Repair System Type: I, II, (II) IV, V, VI

System Description: PRES. DOSED D/B CONV.

Repair System Description: CONV.

Maintenance Agreement Required: ☐ Yes ☑ No

☐ House/Mod. Home ☐ Mobile Home ☐ Business ☑ Other 6256 P.O.

No. Bedrooms No. Bathrooms No. Employees 25

☑ Slab ☐ Crawl Space ☐ Basement w/plumbing ☐ Basement wo/plumbing

Garbage Disposal: ☐ Yes ☑ No

Auto. Dishwasher: ☐ Yes ☑ No


Auto. Washing Machine: ☐ Yes ☑ No

Other

Comments

INITIAL SITE SKETCH

AS BUILT SKETCH

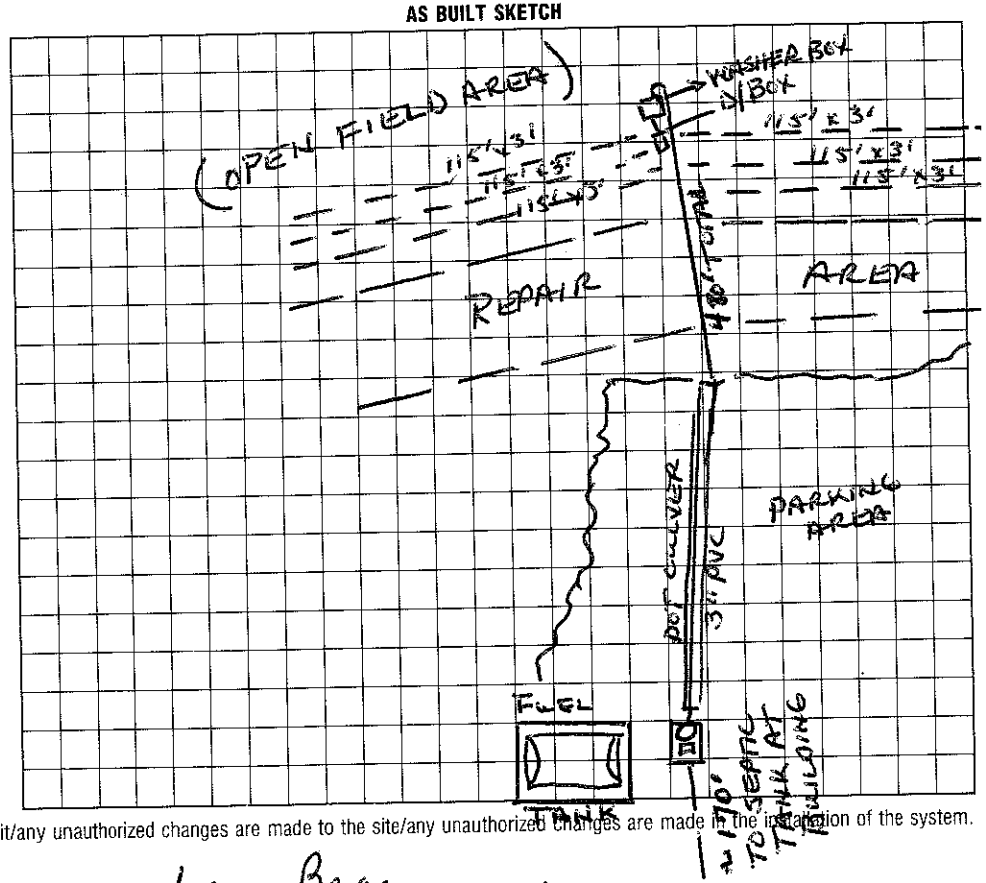

I understand that this permit can be suspended or revoked if any false information is supplied toward securing the permit/any unauthorized changes are made to the site/any unauthorized changes are made in the installation of the system. Improvement Permit is valid for 60 months from date of issuance.

Signed:

Improvement Permit by: date

Existing System Inspection by: date

Installed by: Larry Beam

Certificate of Completion by: Wesley Sparks RS. date 6/11/93

Operation Permit by: date

HEALTH DEPT. COPY: WHITE INSPECTION COPY (FINAL): GREEN OWNER COPY (FINAL): YELLOW INSPECTION COPY (INITIAL): PINK OWNER COPY (INITIAL): GOLD