IREDELL COUNTY HEALTH DEPARTMENT

STATESVILLE 704-878-5305 MOORESVILLE 704-664-5281

IMPROVEMENT PERMIT / AUTHORIZATION TO CONSTRUCT / OPERATION PERMIT / EXISTING SYSTEM INSPECTION

PERMIT # Repair PIN # 4676 173 9169 DATE 3-4-2011

OWNER or APPLICANT Gary Sipes PHONE: Business 704 798-6454 Home: 704 856-8334

OWNER or APPLICANT ADDRESS 1490 Fly Fisher Dr Salisbury, NC 28147

LOCATION / DIRECTIONS Main St (NE) TR Linwood ~ 1.5 miles on left B4 Brumley #487 Linwood

SUBDIVISION _____ BLOCK / SECTION _____ LOT # _____ LOT AREA _____ DESIGN FLOW 240gpd L.T.A.R. .3

Septic Tank 1000 Gallons: STB 825 Date 4-8-11

Pump Tank _____ Gallons: P T _____ Date _____

Pump Make _____ Model 54 Serial # 30044

Nitrification Field No Fields 1 No Lines _____ Lineal Feet 300 ft

Trench Width 36" Max. Trench Bottom Depth 36" Gravel Depth N/A

☐ New System ☒ Repair ☐ Expansion System Type I II III IV V VI

System Description: Gravity - Convent.

Repair System Description: Gravity - 25% Reduction

Maintenance Agreement Required ☐ YES ☐ NO

☒ GRAVITY ☐ PRESSURE

☒ Residence No. Bedrooms 3 ☐ Business No. Persons _____ ☐ Other No. Employees _____

☐ Slab ☐ Crawl Space ☐ Basement w/plumbing ☐ Basement w/o plumbing


Water Supply: ☒ Private ☐ Public ☐ Community

Comments / Conditions: Keep new Septic System at least 10ft from Existing System.


Comments / Conditions: Must keep New Septic at least 50ft from any well (even from old well unless "properly" abandoned). Plumbing in basement must be connected to approved Septic System.

3/14/11 Old well abandoned - therefore drainlines can be extended & extra line added for 300ft (25% Red) total

INITIAL SITE SKETCH

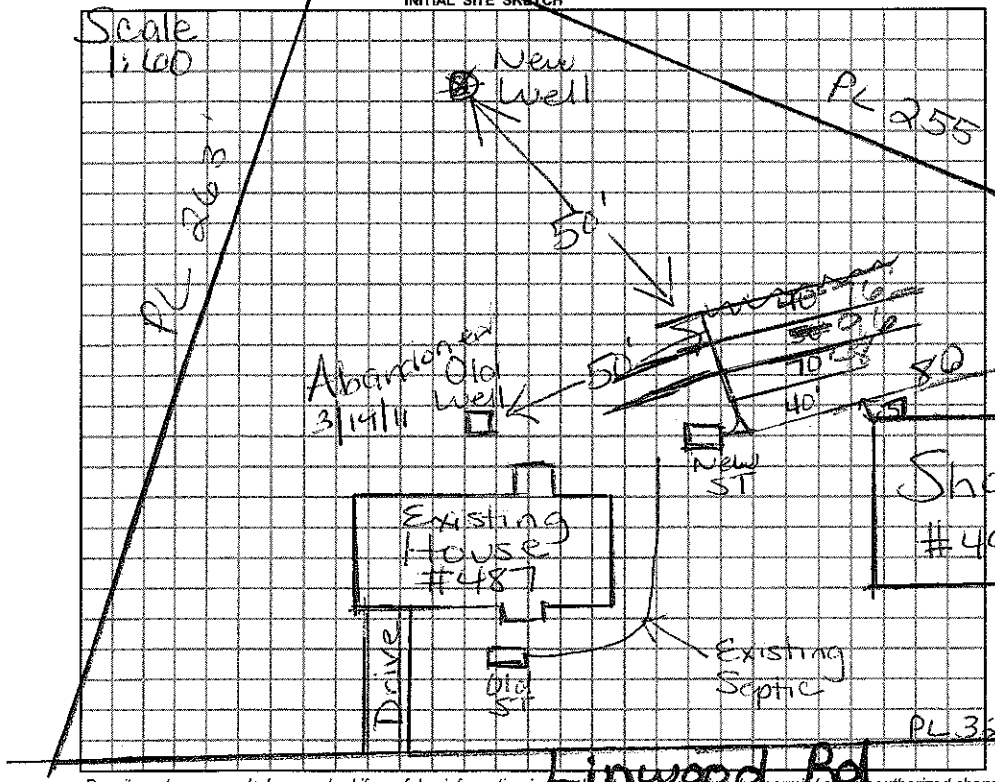

AS BUILT SKETCH

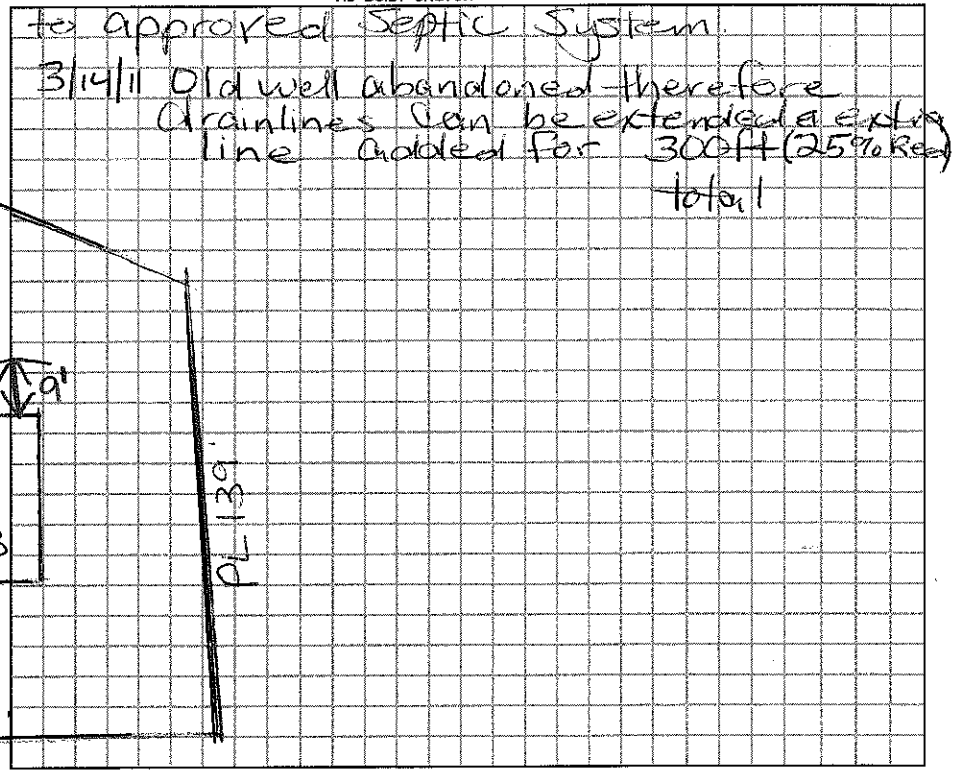

Permit can be suspended or revoked if any false information is supplied toward securing the permit / any unauthorized changes are made to the site / any unauthorized changes are made in the installation of the system.

☐ *IMPROVEMENT PERMIT w / plat valid without expiration.* ☐ *IMPROVEMENT PERMIT w / site plan valid for 60 mos.* ☐ *AUTHORIZATION TO CONSTRUCT valid for period equal to IMPROVEMENT PERMIT-not to exceed 60 mo.*

Owner / Applicant Signature: Gary W. Sipes Date 3-4-2011

Improvement Permit by: Mariah H. Coleman RS Date 3/4/2011

Authorization to Construct by: Mariah H. Coleman RS Date 3/4/2011

Installed by: Delbert Bostian

Operation Permit by: Mariah H. Coleman RS Date: 3/17/11

Existing System Inspected by: _____ Date: _____

YOU SHOULD CONTACT A LOCATOR SERVICE PRIOR TO ANY EXCAVATION.

WHITE COPY Environmental Health YELLOW COPY (Final) Owner / Applicant PINK COPY (Initial) Owner / Applicant