# IREDELL COUNTY HEALTH DEPARTMENT

STATESVILLE 704-878-5305 MOORESVILLE 704-664-5281

4676211240 3 3e

## IMPROVEMENT PERMIT / CERTIFICATE OF COMPLETION / OPERATION PERMIT / EXISTING SYSTEM INSPECTION

PROPERTY DESCRIPTION NO. Repair DATE 4/24/96 TAX MAP NO.

OWNER OR CONTRACTOR Merrill McKnight PHONE: Business Home 664-1924 Watershed: ☐ Yes ☐ No

ADDRESS 190 Williford Rd Mooresville 28115

LOCATION 1365 S to Williford Rd

SUBDIVISION BLOCK / SECTION LOT LOT AREA SITE CLASS. PS DESIGN FLOW 360 L.T.A.R.

Septic Tank: 1000 Gallons; STB Date

Pump Tank: Gallons; PT Date

Pump Make: Model Serial No.

Nitrification Field: No Fields 1 Square Feet 900 Linear Feet 300

No Lines 3 Trench Width 36" Max Trench Bottom Depth 36" Gravel Depth 12"

☐ New System ☑ Repair System Type: I, II, III, IV, V, VI

System Description: Gravity Conventional

Repair System Description:

Maintenance Agreement Required: ☐ Yes ☐ No

☑ House/Mod. Home No. Bedrooms 3

☐ Mobile Home No. Bathrooms 2

☐ Business No. Employees

☐ Other


☐ Slab ☑ Crawl Space ☐ Basement w/plumbing ☐ Basement wo/plumbing

Water Supply: ☑ Individual ☐ Community ☐ Public

Comments:

Comments:

INITIAL SITE SKETCH

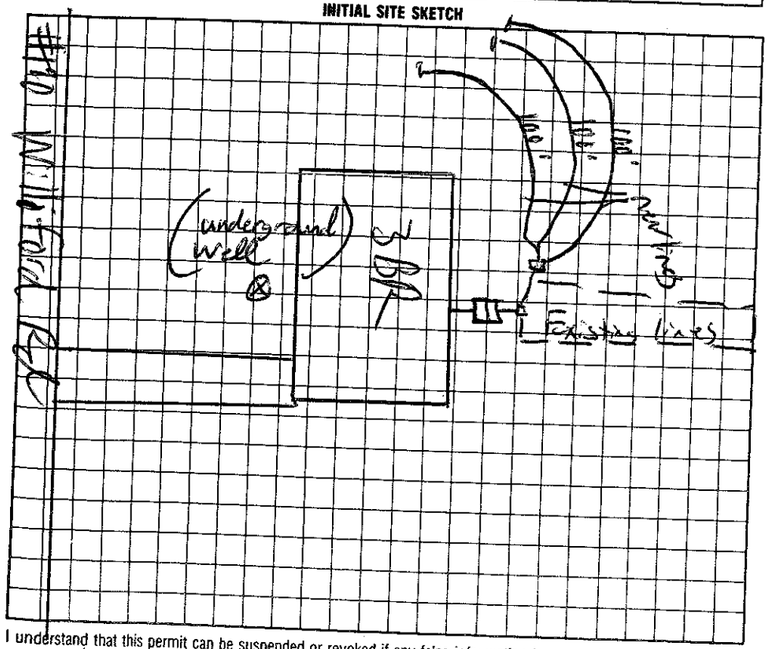


AS BUILT SKETCH

I understand that this permit can be suspended or revoked if any false information is supplied toward securing the permit/any unauthorized changes are made to the site/any unauthorized changes are made in the installation of the system.

Signed: Merrill McKnight

Improvement Permit by: [illegible] EHS date 4/24/96

Existing System Inspection by: [illegible] EHS date 4/25/96

Installed by: Lavon Benton

Certificate of Completion by: date

Operation Permit by: Wesley Sparks RS. date 5/8/96

HEALTH DEPT. COPY: WHITE INSPECTION COPY (FINAL): GREEN OWNER COPY (FINAL): YELLOW INSPECTION COPY (INITIAL): PINK OWNER COPY (INITIAL): GOLD