IREDELL COUNTY HEALTH DEPARTMENT

STATESVILLE 704-878-5305 MOORESVILLE 704-664-5281

IMPROVEMENT PERMIT / AUTHORIZATION TO CONSTRUCT / OPERATION PERMIT / EXISTING SYSTEM INSPECTION

D

PERMIT# N/A PIN# N/A 4676215695 DATE 2/9/04

OWNER OR CONTRACTOR Michael E Perry PHONE: Business Home 704-663-1341

ADDRESS 106 Willow Oak Ln Mooresville, NC. 28115

LOCATION 3 South to Williford Rd. to Willow Oak Ln., first house on (R)

SUBDIVISION BLOCK / SECTION LOT LOT AREA .46 AC SITE CLASS. DESIGN FLOW L.T.A.R.

Septic Tank: EXIST. Gallons; STB Date
Pump Tank: 1000 Gallons; PT Date
Pump Make: Model Serial No.
Nitrification Field: No. Fields 1 Square Feet 900 Linear Feet 300
No. Lines ~~10~~ 15 Trench Width 3' Max Trench Bottom Depth 3' Gravel Depth N/A

☐ New System ☒ Repair System Type: I, II, III, IV, V, VI
System Description: PM → 25% Reduced
Repair System Description: PM → 25% Reduced
Maintenance Agreement Required: ☐ Yes ☒ No


☒ House/Mod. Home No. Bedrooms 3
☐ Mobile Home No. Bathrooms 3
☐ Business No. Employees
☐ Other
☐ Slab ☒ Crawl Space ☐ Basement w/plumbing ☐ Basement wo/plumbing

Water Supply: ☐ Individual ☐ Public ☐ Community


Comments:/Conditions: 100' x 9-10' E2 FLOW BED INSTALLED

Comments:/Conditions: Pete's Dug 3/23/04 Drainfield changed after evaluating pits w/FJ Ervin - See as built

INITIAL SITE SKETCH

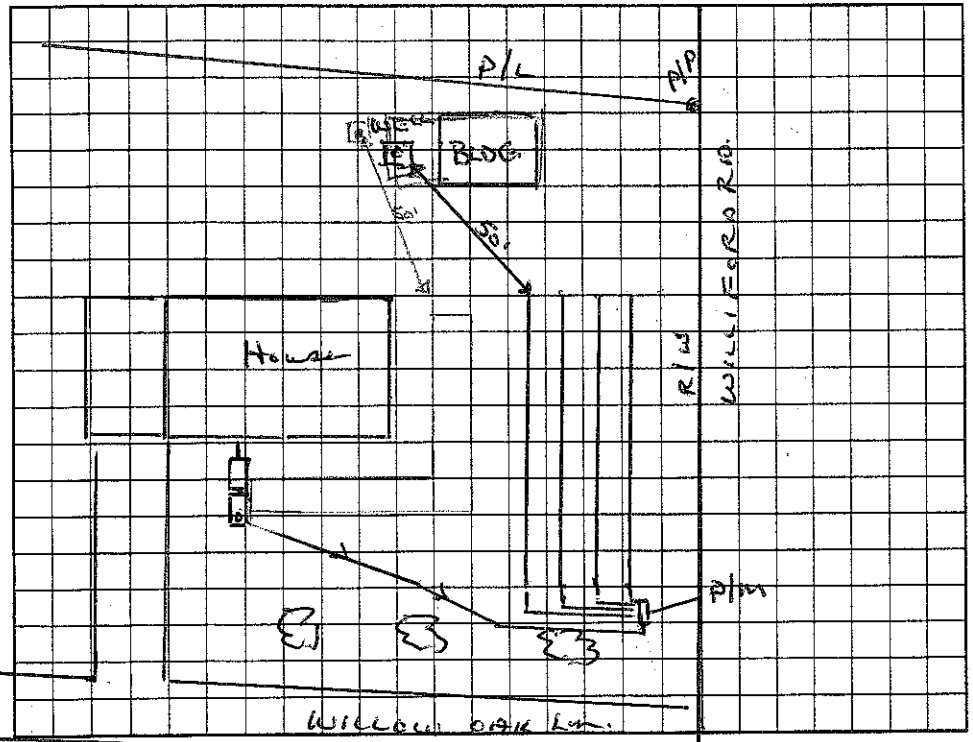

AS-BUILT SKETCH

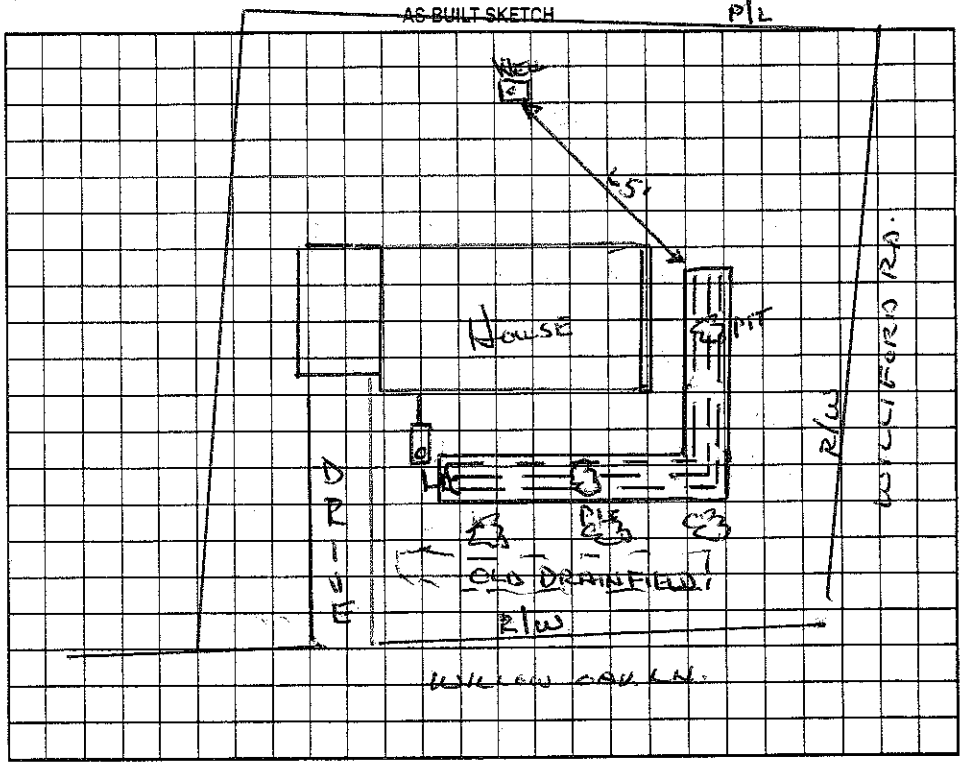

Permit can be suspended or revoked if any false information is supplied toward securing the permit/any unauthorized changes are made to the site/any unauthorized changes are made in the installation of the system. Improvement Permit with plat valid without expiration. Improvement Permit with site plan valid for sixty months. Authorization to Construct is valid for a period equal to that of Improvement Permit – not to exceed sixty months.

Signed: Michael E. Perry date 2-10-04 Installed by: FJ Ervin

Improvement Permit by: Wesley Sparks RS. date 2/9/04 Operation Permit by: Wesley Sparks RS. date 3/24/04

Authorization to Construct by: Wesley Sparks RS date 2/9/04 Existing System Inspection by: date

HEALTH DEPT. COPY: WHITE OWNER COPY (FINAL): YELLOW OWNER COPY (INITIAL): PINK