# IREDELL COUNTY HEALTH DEPARTMENT

STATESVILLE 704-878-5305 130.00 Paid MOORESVILLE 704-664-5281

## IMPROVEMENT PERMIT / AUTHORIZATION TO CONSTRUCT / OPERATION PERMIT / EXISTING SYSTEM INSPECTIO

PERMIT# 105225 PIN# 4676 21 7864 DATE 4/22/02

OWNER OR CONTRACTOR Pageant Corporation PHONE: Business 704-662-9555 Home

ADDRESS 4717 Durango Rd. Santa Rosa, Calif

LOCATION 136 S to Williford Rd. on (L) just past Willow Oak Ln, #1441

SUBDIVISION No BLOCK / SECTION LOT No LOT AREA ~1.6 AC SITE CLASS PS DESIGN FLOW 480 L.T.A.R. .125

Septic Tank: 1000 Gallons; STB S 794 Date 6-11-02

Pump Tank: 1000 Gallons; PT 4" 85 gpm Date 8-18-02

Pump Make Goulds Model 4" Serial No 50350342 1

Nitification Field: No Fields 1 Square Feet 1440 Linear Feet 480

No Lines 6@80' Trench Width 3' Max Trench Bottom Depth 3'

[X] New System [ ] Repair System Type: I, II, (III) IV, V, VI

System Description: Pres Man to EZ Flow / CH. PLASTIC

Repair System Description: 16" APBAS - Pres Dosed

Maintenance Agreement Required: [ ] Yes [X] No

Gravel Depth No [ ] Slab [X] Crawl Space [ ] Basement w/plumbing [ ] Basement wo/plumbing

[X] House/Mod. Home No. Bedrooms 4

[ ] Mobile Home No. Bathrooms 3

[ ] Business No. Employees

[ ] Other


Water Supply: [X] Individual [ ] Public [ ] Community

Comments:/Conditions:


Comments:/Conditions: Checked tanks & lines & press. 10/2/2002

INITIAL SITE SKETCH

(1"=60')

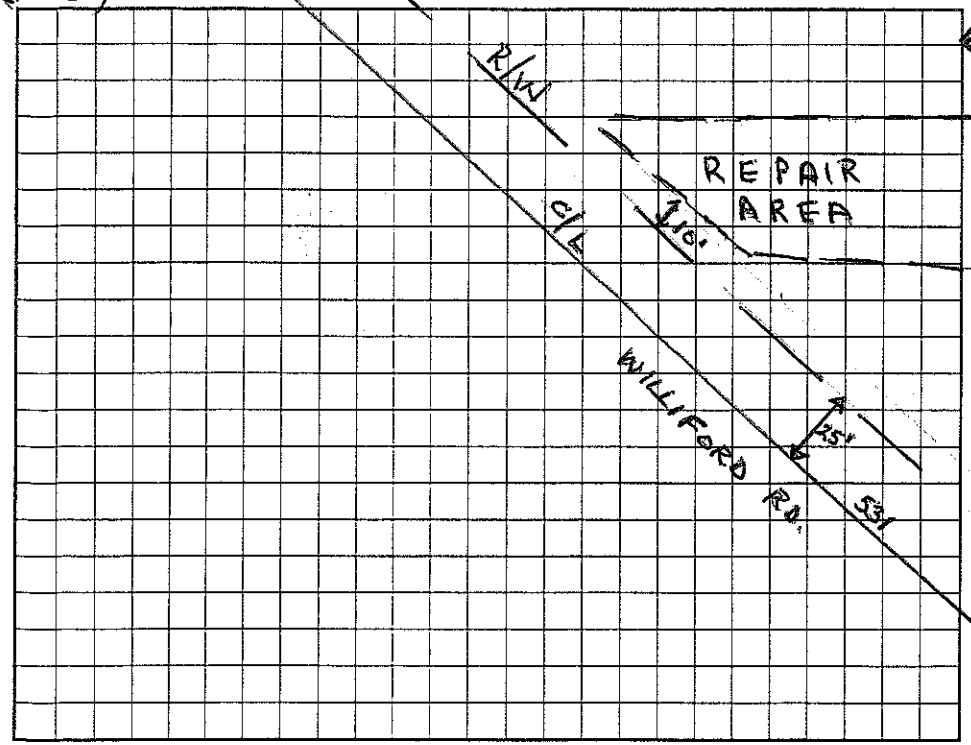


AS BUILT SKETCH

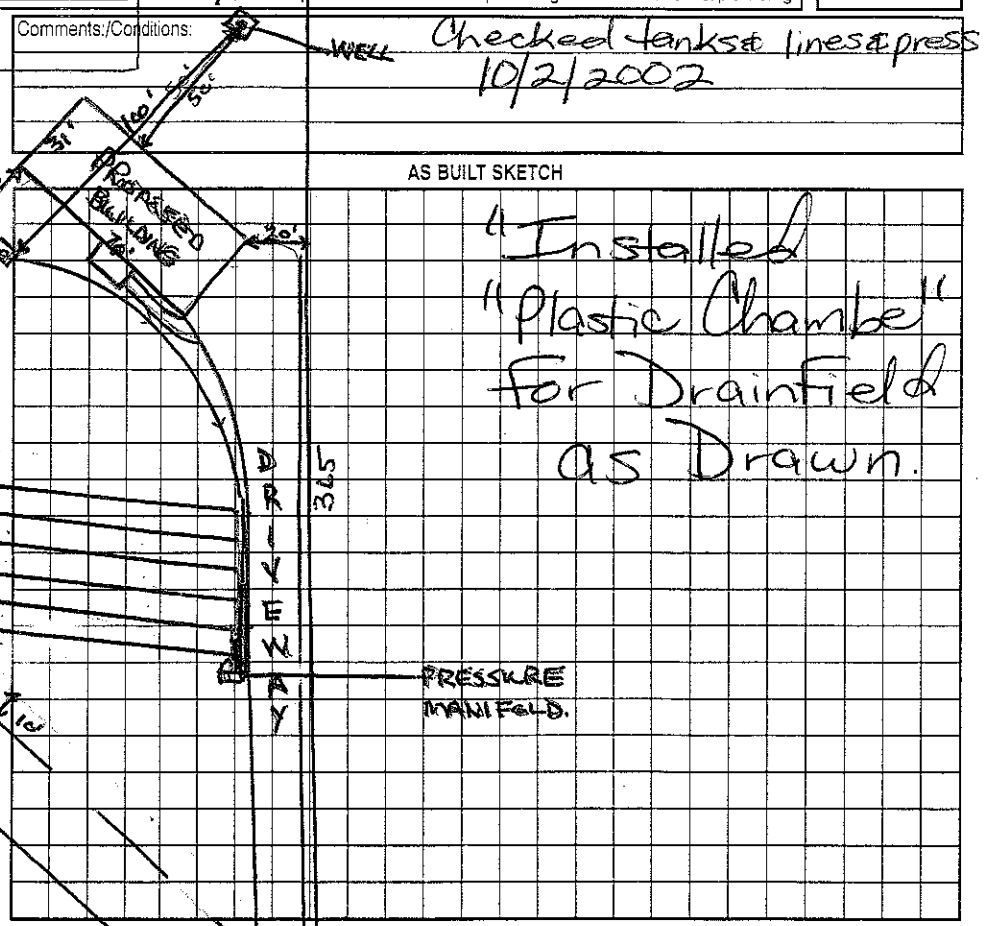


4 Installed "Plastic Chamber" for Drainfield as Drawn.

Permit can be suspended or revoked if any false information is supplied toward securing the permit/any unauthorized changes are made to the site/any unauthorized changes are made in the installation of the system. Improvement Permit with plat valid without expiration. Improvement Permit with site plan valid for sixty months. Authorization to Construct is valid for a period equal to that of Improvement Permit – not to exceed sixty months.

Signed: * date 4-23-02 Installed by: F.J. Ervin RS

Improvement Permit by: Wesley Sparks RS. date 4/22/02 Operation Permit by: Maint. Tech date 10/4/2002

Authorization to Construct by: Wesley Sparks RS date 4/23/02 Existing System Inspection by: date

HEALTH DEPT. COPY: WHITE OWNER COPY (FINAL): YELLOW OWNER COPY (INITIAL): PINK