IREDELL COUNTY HEALTH DEPARTMENT

STATESVILLE 704-878-5305 130.00 Paid MOORESVILLE 704-664-5281 10.00

IMPROVEMENT PERMIT / AUTHORIZATION TO CONSTRUCT / OPERATION PERMIT / EXISTING SYSTEM INSPECTION

DATE 4/22/02

PERMIT# 105225 PIN# 4676 21 7864

OWNER OR CONTRACTOR Pageant Corporation PHONE: Business 704-662-9555 Home

ADDRESS 4717 Duenza Rd. Santa Rosa, Calif #1441

LOCATION 1365 TL Williford Rd. on (L) just past Willow Oak Ln.

SUBDIVISION No BLOCK / SECTION LOT No LOT AREA ~1.6AC SITE CLASS PS DESIGN FLOW 480 L.T.A.R. .25

Septic Tank: 1000 Gallons; STB 794 Date 10-11-02

Pump Tank: 1000 Gallons; PT 37 Date 8-18-02

Pump Make Goulds Model 4HP05 Serial No. 50350321

Nitification Field: No Fields 1 Square Feet 1440 Linear Feet 480

No Lines 6@80' Trench Width 3' Max Trench Bottom Depth 3' Gravel Depth No

[X] New System [ ] Repair System Type: I. II. III. IV. V. VI

System Description: PreMan to EZflow/CH. PLASTIC

Repair System Description: 16" ABS - Three Dosed

Maintenance Agreement Required: [ ] Yes [X] No

[ ] Slab [X] Crawl Space [ ] Basement w/plumbing [ ] Basement w/o plumbing

[X] House/Mod. Home [ ] Mobile Home [ ] Business [ ] Other


No. Bedrooms 4 No. Bathrooms 3 No. Employees

Water Supply: [X] Individual [ ] Public [ ] Community


Comments/Conditions:

Comments/Conditions: Checked tanks & lines & pressed 10/2/2002

INITIAL SITE SKETCH (1"=20')

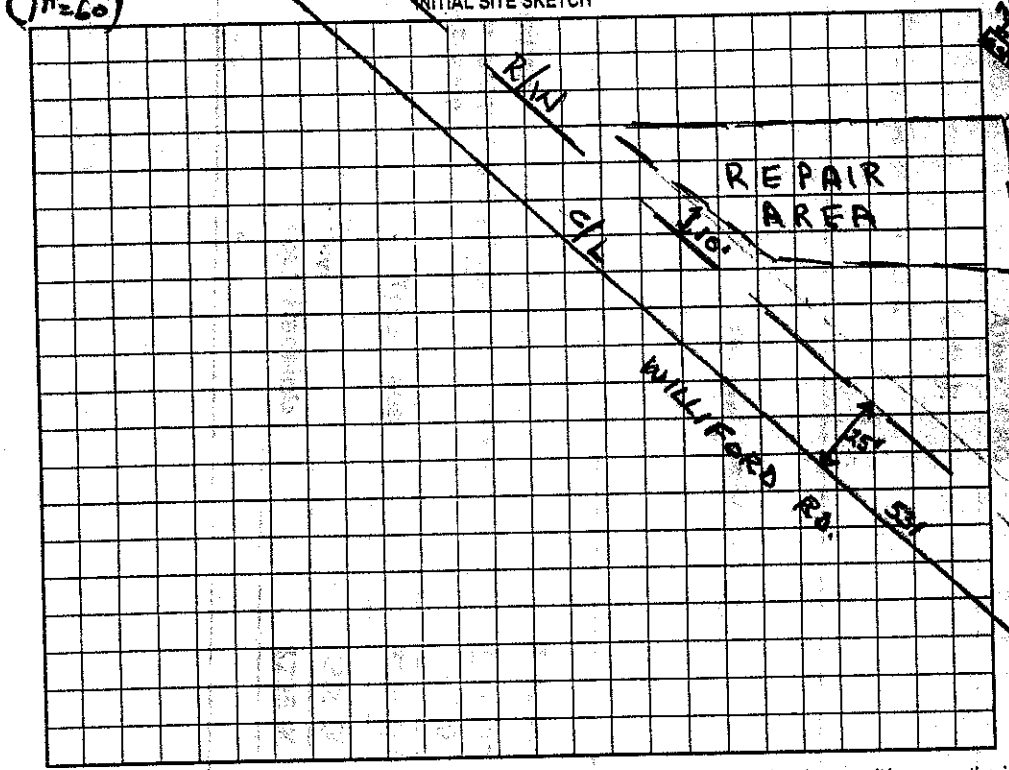

AS BUILT SKETCH

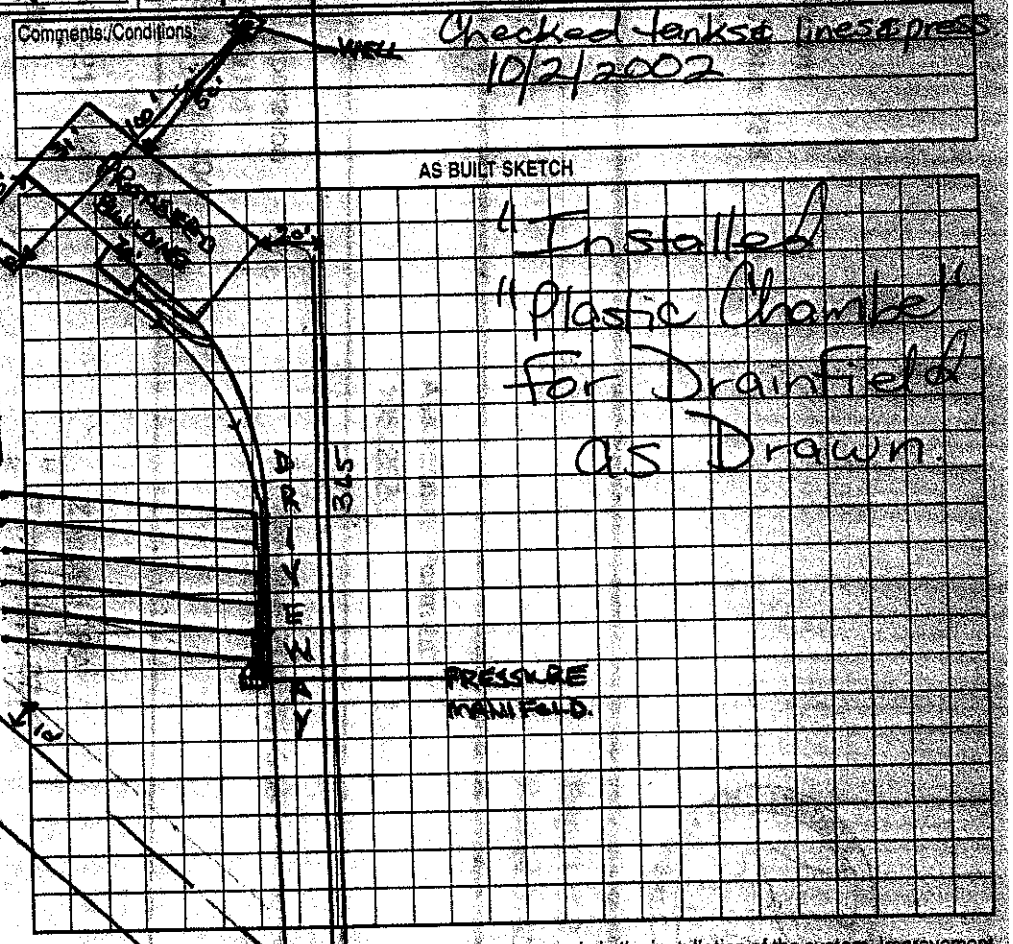

Permit can be suspended or revoked if any false information is supplied toward securing the permit/any unauthorized changes are made to the site/any unauthorized changes are made in the installation of the system. Improvement Permit with plat valid without expiration. Improvement Permit with site plan valid for sixty months. Authorization to Construct is valid for a period equal to that of Improvement Permit – not to exceed sixty months.

Signed: * date 4-23-02 Installed by: F.J. Ervin RS date 10/4/02

Improvement Permit by: Wesley Sparks RS. date 4/22/02 Operation Permit by: Mark H. Dotson date

Authorization to Construct by: Wesley Sparks RS date 4/23/02 Existing System Inspection by: date