IREDELL COUNTY HEALTH DEPARTMENT

STATESVILLE 704-878-5305 MOORESVILLE 704-664-5281

IMPROVEMENT PERMIT / AUTHORIZATION TO CONSTRUCT / OPERATION PERMIT / EXISTING SYSTEM INSPECTION

PERMIT # REPAIR PIN # 4676-23-2320 DATE 3/6/09

OWNER or APPLICANT SOUTH IREDELL VOL. FIRE DEPARTMENT PHONE: Business 704-664-3043 Home:

OWNER or APPLICANT ADDRESS 716 LINWOOD RD. MOORESVILLE, NC. 28115

LOCATION / DIRECTIONS MAIN ST TR LINWOOD RD. TO 716 ON (R) PAST BRUMLEY RD. INTERSECTION

SUBDIVISION NO BLOCK / SECTION LOT # LOT AREA DESIGN FLOW 100 L.T.A.R.

Septic Tank 1000 Gallons: STB 794 Date 2/3/08
Pump Tank Gallons: P T Date
Pump Make Model Serial #
Nitrification Field No Fields No Lines EXISTING Linear Feet
Trench Width Max. Trench Bottom Depth Gravel Depth


☐ New System ☒ Repair ☐ Expansion System Type I (II) III IV V VI
System Description:
Repair System Description: REPLACE S/T W 1000GAL S/T
Maintenance Agreement Required ☐ YES ☒ NO
☐ GRAVITY ☐ PRESSURE

☐ Residence No. Bedrooms ☐ Business No. Persons ☒ Other No. Employees 4
☐ Slab ☐ Crawl Space ☐ Basement w/plumbing ☐ Basement w/o plumbing

Water Supply: ☒ Private ☐ Public ☐ Community

Comments / Conditions: SET NEW 1000GAL. S/T WITH FILTER, TIE INTO EXISTING DRAINFIELD.

INITIAL SITE SKETCH

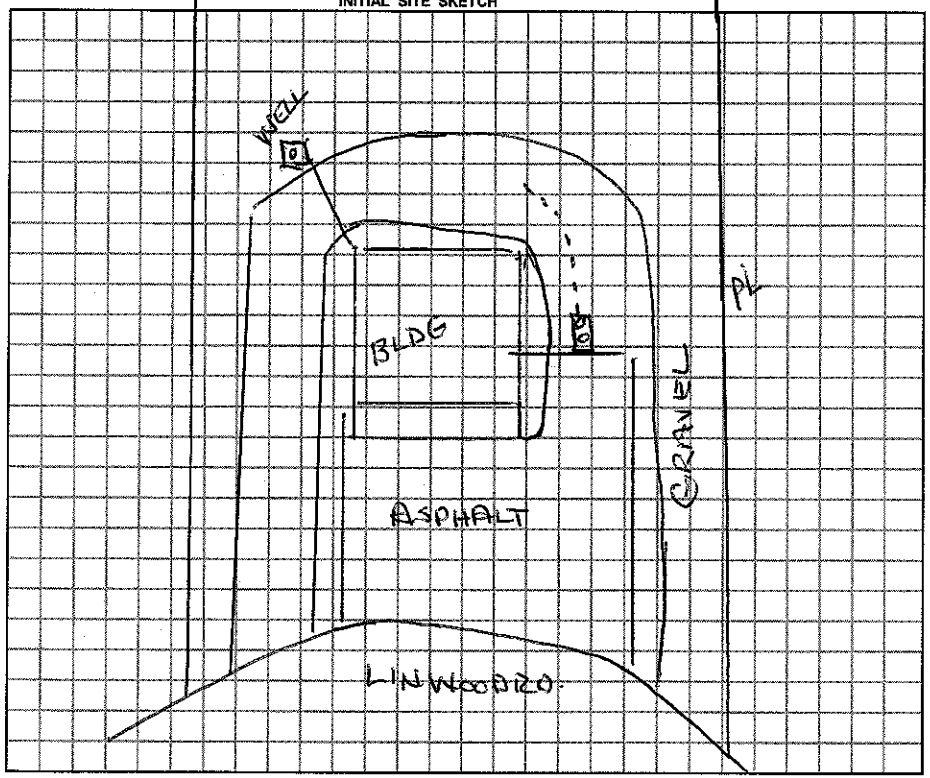

Comments / Conditions

AS BUILT SKETCH

Permit can be suspended or revoked if any false information is supplied toward securing the permit / any unauthorized changes are made to the site / any unauthorized changes are made in the installation of the system.

☐ *IMPROVEMENT PERMIT w / plat valid without expiration.* ☐ *IMPROVEMENT PERMIT w / site plan valid for 60 mos.* ☒ *AUTHORIZATION TO CONSTRUCT valid for period equal to IMPROVEMENT PERMIT-not to exceed 60 mo.*

Owner / Applicant Signature: Date

Improvement Permit by: Wesley Sparks RS Date 3/6/09

Authorzation to Construct by: Wesley Sparks RS Date 3/6/09

YOU SHOULD CONTACT A LOCATOR SERVICE PRIOR TO ANY EXCAVATION.

Installed by: Orbison

Operation Permit by: Wesley Sparks RS. Date: 3/6/09

Existing System Inspected by: Date:

WHITE COPY Environmental Health YELLOW COPY (Final) Owner / Applicant PINK COPY (Initial) Owner / Applicant