3:00 F

IREDELL COUNTY HEALTH DEPARTMENT

STATESVILLE 704-878-5305 MOORESVILLE 704-664-5281

IMPROVEMENT PERMIT / AUTHORIZATION TO CONSTRUCT / OPERATION PERMIT / EXISTING SYSTEM INSPECTION

PERMIT# 138353 PIN# 4676238811

OWNER OR APPLICANT Bryan Todd Neel PHONE: Business 902-0210 Home 660-5868 DATE 10-3-06

ADDRESS 115 Elmhurst Ln Mooresville, NC 28115

LOCATION Main St TR Linwood Rd TL Windchime lot on right

SUBDIVISION Quail Run BLOCK / SECTION 3 LOT 9 LOT AREA 2.095 Acre SITE CLASS. PS DESIGN FLOW 480 gpd L.T.A.R. .3

Septic Tank: 1000 Gallons; STB 825 Date 2/18/07

Pump Tank: ____ Gallons; PT ____ Date ____

Pump Make: ____ Model ____ Serial No. ____

Nitrification Field: No Fields 1 Square Feet ____ Linear Feet 535'

No Lines 5@107' Trench Width 36" Max Trench Bottom Depth 36

[X] New System [ ] Repair [ ] Expansion System Type: I II III IV V VI

System Description: Gravity-Conventional

Repair System Description: Same

Maintenance Agreement Required: [ ] Yes [X] No

Gravel Depth 12" [X] Gravity [ ] Pressure [ ] Slab [ ] Crawl Space [X] Basement w/plumbing [ ] Basement wo/plumbing

[X] House/Mod. Home No. Bedrooms 4

[ ] Mobile Home No. Persons ____


[ ] Business No. Employees ____

[ ] Other ____

Water Supply: [X] Individual [ ] Public [ ] Community

Comments/Conditions: Note: Stub out plumbing on high side of house to keep gravity flow to ST. Keep ST at least 25'+ from basement wall.

INITIAL SITE SKETCH

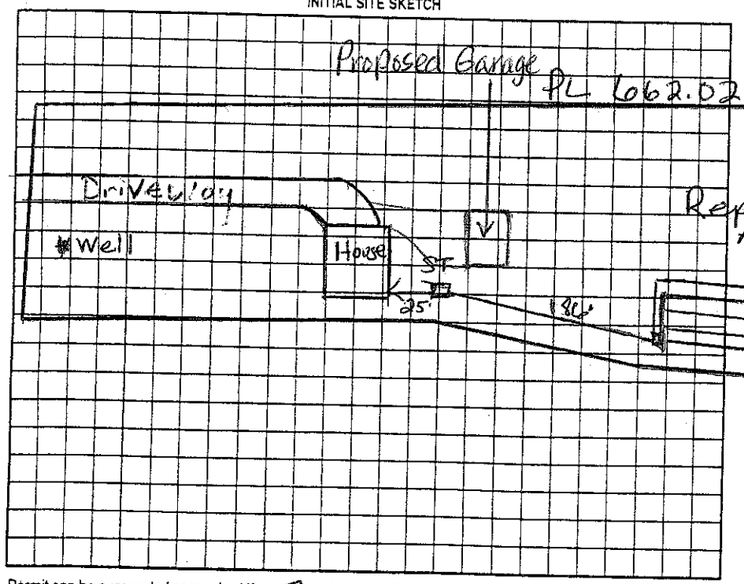

Comments/Conditions: Owner using "Grinder pump" for basement plumbing.

Shift Director installed (400')

AS BUILT SKETCH

The proposed / existing Garage 26' x 32' addition does not appear to impact the existing septic system.

**NOTE: Shall be min. 5' from ST

Judy Melville R.S.

Date: 10-11-17

ICHD-Environmental Health Division

Permit can be suspended or revoked if any false information is supplied toward securing the permit/any unauthorized changes are made to the site/any unauthorized changes are made in the installation of the system. Improvement Permit with plat valid without expiration ☐ Improvement Permit with site plan valid for sixty months ☐ Authorization to Construct is valid for a period equal to that of Improvement Permit – not to exceed sixty months.

Signed: B. Todd Neel date ____

Improvement Permit by: Maina Watson RS date 10/3/06

Authorization to Construct by: Maina Watson RS date 10/3/06

Installed by: Rowan Septic Tank

Operation Permit by: Wesley Sparks R.S. date 4/23/07

Existing System Inspection by: ____ date ____

HEALTH DEPT. COPY: WHITE OWNER COPY (FINAL): YELLOW OWNER COPY (INITIAL): PINK