IREDELL COUNTY HEALTH DEPARTMENT

→ AUTHORIZATION TO CONSTRUCT

STATESVILLE 704-878-5305 MOORESVILLE 704-664-5281

IMPROVEMENT PERMIT / ~~CERTIFICATE OF COMPLETION~~ / OPERATION PERMIT / EXISTING SYSTEM INSPECTION

PROPERTY DESCRIPTION NO. 25933 DATE 2/1/97 TAX MAP NO. 4676268504 Watershed: ☑ Yes ☐ No

OWNER OR CONTRACTOR CONNIE L. BAXTER PHONE: Business _____ Home 660-5165

ADDRESS 127 WOODWINDS DR. MOORESVILLE NC 28115

LOCATION [redacted] LINWOOD RD - TL BRUMLEY RD - TR WOODWINDS DR 2ND LOT ON LEFT

SUBDIVISION QUAIL HILL BLOCK / SECTION — LOT 89 LOT AREA — SITE CLASS. PS DESIGN FLOW 360 GPD L.T.A.R. .36 PD/FT²

Septic Tank: 1000 Gallons; STB 794 Date 12-2-96

Pump Tank: _____ Gallons; PT _____ Date _____

Pump Make: _____ Model _____ Serial No. _____

Nitrification Field: No Fields 1 Square Feet 1200 Linear Feet 400

No Lines 5@80' Trench Width 36" Max Trench Bottom Depth 36" Gravel Depth 12"

☑ New System ☐ Repair System Type: I, II, III, IV, V, VI

System Description: GRAVITY CONVENTIONAL

Repair System Description: GRAVITY PANEL

Maintenance Agreement Required: ☐ Yes ☑ No

☐ House/Mod. Home ☑ Mobile Home ☐ Business ☐ Other

No. Bedrooms 3 No. Bathrooms 2 No. Employees ____


☐ Slab ☑ Crawl Space ☐ Basement w/plumbing ☐ Basement wo/plumbing

Water Supply: ☑ Individual ☐ Community ☐ Public

Comments:

Comments:

INITIAL SITE SKETCH

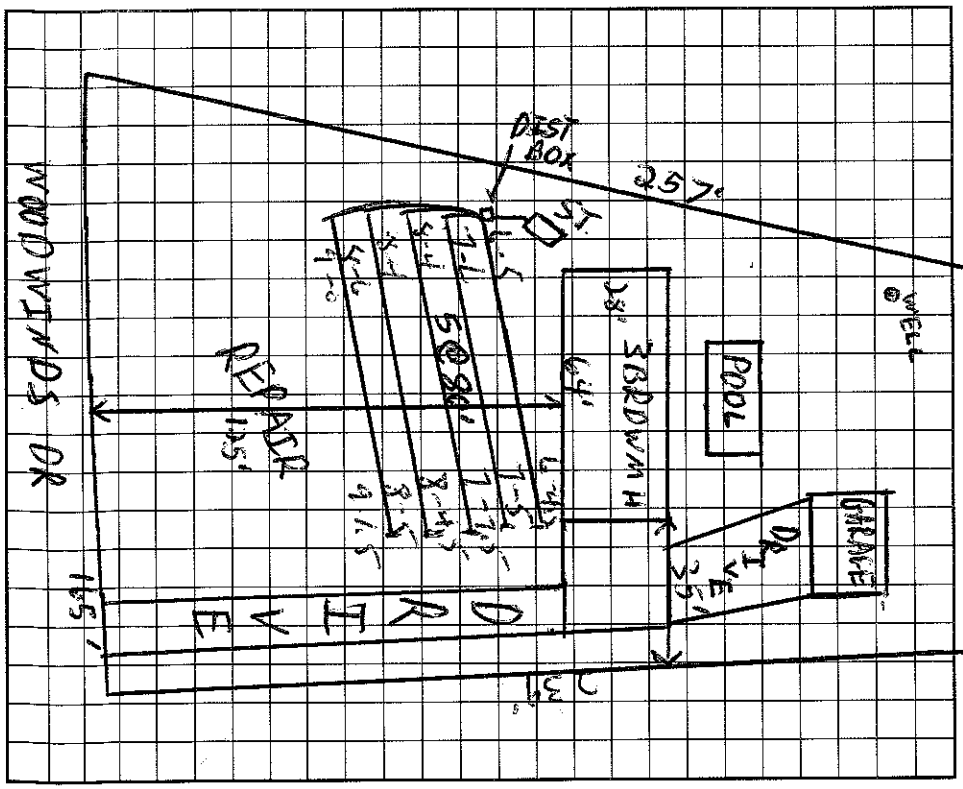

AS BUILT SKETCH

I understand that this permit can be suspended or revoked if any false information is supplied toward securing the permit/any unauthorized changes are made to the site/any unauthorized changes are made in the installation of the system. Improvement Permit is valid for 60 months from date of issuance.

Signed: Connie Lee Baxter

Improvement Permit by: [signature] EHSL date 2/1/97

Existing System Inspection by: [signature] EHSL date 2/1/97

Installed by: Roger Caldwell

Certificate of Completion by: _____ date _____

Operation Permit by: Wesley Sparks R.S. date 3/31/97

HEALTH DEPT. COPY: WHITE INSPECTION COPY (FINAL): GREEN OWNER COPY (FINAL): YELLOW INSPECTION COPY (INITIAL): PINK OWNER COPY (INITIAL): GOLD