IREDELL COUNTY HEALTH DEPARTMENT

STATESVILLE 704-878-5305 MOORESVILLE 704-664-5281

IMPROVEMENT PERMIT / CERTIFICATE OF COMPLETION / OPERATION PERMIT / EXISTING SYSTEM INSPECTION

PROPERTY DESCRIPTION NO. 083877 DATE 11/2/99 TAX MAP NO. 4676 31 3199 Watershed: ☒ Yes ☐ No

OWNER OR CONTRACTOR Johnny Wright PHONE: Business _____ Home 892-5624

ADDRESS 324 Tarheel Lane Mooresville, NC. 28115 – 163 Wellford Rd.

LOCATION 1365 TL Wellford Rd TR after 4th house on ground, follow to old on R

SUBDIVISION No BLOCK / SECTION _____ LOT _____ LOT AREA EXISTING SITE CLASS. _____ DESIGN FLOW 360 L.T.A.R. _____

Septic Tank: EXISTING Gallons; STB _____ Date _____

Pump Tank: _____ Gallons; PT _____ Date _____

Pump Make: _____ Model _____ Serial No. _____

Nitrification Field: No Fields _____ Square Feet EXISTING SYSTEM Linear Feet _____

No Lines _____ Trench Width _____ Max Trench Bottom Depth _____ Gravel Depth _____

☐ New System ☐ Repair System Type: I (II) III, IV, V, VI

System Description: EXISTING

Repair System Description: _____

Maintenance Agreement Required: ☐ Yes ☒ No

☐ House/Mod. Home No. Bedrooms 2

☒ Mobile Home No. Bathrooms 1

☐ Business No. Employees _____

☐ Other _____

☐ Slab ☐ Crawl Space ☐ Basement w/plumbing ☐ Basement wo/plumbing


Water Supply:
☒ Individual
☐ Community
☐ Public

Comments:

Comments:

INITIAL SITE SKETCH

AS BUILT SKETCH

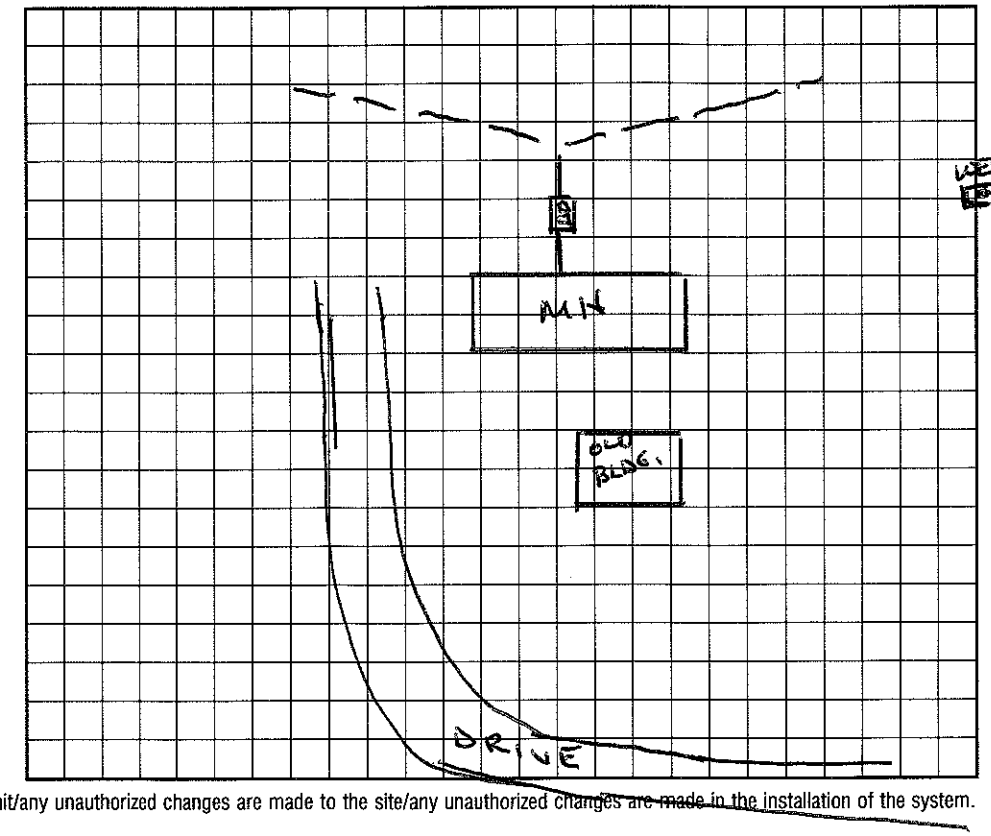

I understand that this permit can be suspended or revoked if any false information is supplied toward securing the permit/any unauthorized changes are made to the site/any unauthorized changes are made in the installation of the system. Improvement Permit is valid for 60 months from date of issuance.

Signed: _____

Improvement Permit by: _____ date _____

Existing System Inspection by: _____ date _____

Installed by: _____

Certificate of Completion by: _____ date _____

Operation Permit by: Wesley Sparks RS. date 11/2/99

HEALTH DEPT. COPY: WHITE INSPECTION COPY (FINAL): GREEN OWNER COPY (FINAL): YELLOW INSPECTION COPY (INITIAL): PINK OWNER COPY (INITIAL): GOLD