IREDELL COUNTY HEALTH DEPARTMENT

STATESVILLE 704-878-5305 MOORESVILLE 704-664-5281

IMPROVEMENT PERMIT / AUTHORIZATION TO CONSTRUCT / OPERATION PERMIT / EXISTING SYSTEM INSPECTION

PERMIT# 104766 PIN# 4676 32 4215 DATE 2/28/02

OWNER OR CONTRACTOR Douglas Allen PHONE: Business 704-932-1837 Home

ADDRESS 135 Williford Rd. Mooresville, NC. 28115

LOCATION 1365 Tr Williford Rd. (R) corner of Williford and Linwood Rd.

SUBDIVISION No BLOCK / SECTION LOT LOT AREA ~1.2ac SITE CLASS. PS DESIGN FLOW L.T.A.R. .3

Septic Tank: 1000 Gallons; STB 312 Date 5/28/02
Pump Tank: Gallons; PT Date
Pump Make: Model Serial No.
Nitrification Field: No Fields 1 Square Feet 1200 Linear Feet 400
No Lines 3@133' Trench Width 3' Max Trench Bottom Depth 36" Gravel Depth 12"

☑ New System ☐ Repair System Type: I (II) III. IV. V. VI
System Description: GRAV - CONVENTIONAL
Repair System Description: GRAV - Typ 3
Maintenance Agreement Required: ☐ Yes ☒ No

☑ House/Mod. Home No. Bedrooms 3
☐ Mobile Home No. Bathrooms 3
☐ Business No. Employees
☐ Other
☐ Slab ☒ Crawl Space ☐ Basement w/plumbing ☐ Basement wo/plumbing


Water Supply:
☒ Individual
☐ Public
☐ Community

Comments:/Conditions:


Comments:/Conditions: Conventional Installed.

(1" = 50')

INITIAL SITE SKETCH

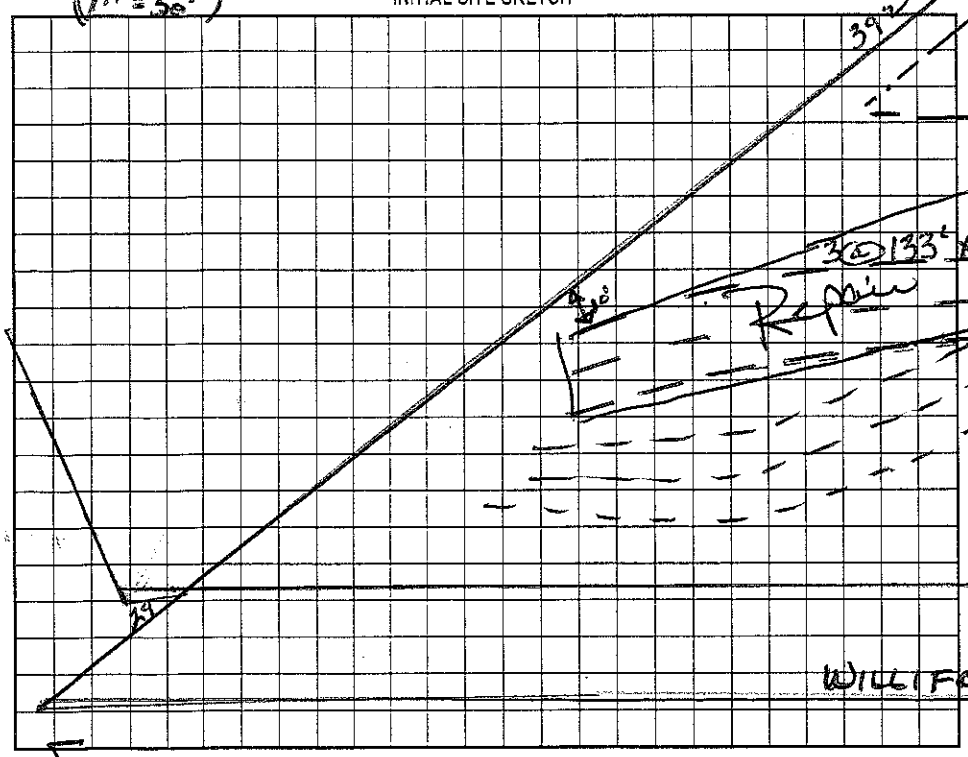

AS BUILT SKETCH

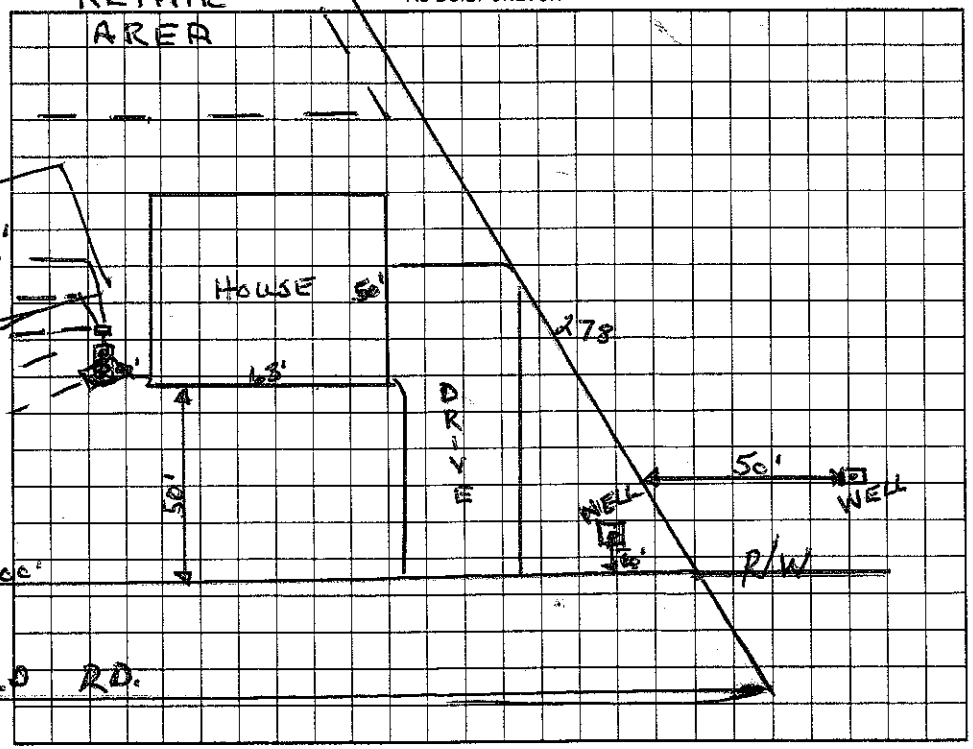

Permit can be suspended or revoked if any false information is supplied toward securing the permit/any unauthorized changes are made to the site/any unauthorized changes are made in the installation of the system. Improvement Permit with plat valid without expiration. Improvement Permit with site plan valid for sixty months. Authorization to Construct is valid for a period equal to that of Improvement Permit – not to exceed sixty months.

Signed * Douglas D. Allen date 3-1-02 Installed by: Larry Tucker

Improvement Permit by: Wesley Sparks RS. date 2/28/02 Operation Permit by: Wesley Sparks RS date 7/2/02

Authorization to Construct by: Wesley Sparks RS. date 2/28/02 Existing System Inspection by: date

HEALTH DEPT. COPY: WHITE OWNER COPY (FINAL): YELLOW OWNER COPY (INITIAL): PINK