IREDELL COUNTY HEALTH DEPARTMENT

Statesville Office (704) 878-5305 Mooresville Office (704) 660-3625 PERMIT # 212620

IMPROVEMENT PERMIT / AUTHORIZATION TO CONSTRUCT / OPERATION PERMIT / EXISTING SYSTEM

PIN # 4676-32-7363.000

APPLICANT: Maximiliano Martinez APPLICANT ADDRESS: 802 Linwood Rd. Mooresville NC, 28115

SITE ADDRESS: 802 Linwood Rd. Mooresville NC 28115 PHONE: 704-245-9028 ALT. PHONE:

SITE DIRECTIONS: Main St. TR Linwood, Site on R

SUBDIVISION: Quail Run No. 2 SECTION: LOT # 16 LOT AREA: DESIGN FLOW: Ex. 360 GPD T.A.R.: Existing

Septic Tank	Existing	(gal)	STB	Date	☐ New System	☐ Repair	☐ Expansion	System Type: ☒ I ☐ II ☐ III ☐ IV ☐ V ☐ VI	☒ Residence	No. Bedrooms	Ex. 3	Water Supply
Pump Tank		(gal)	PT	Date	System Description: Existing Conventional - Gravity				☐ Business	No. Persons	Ex 6	☒ Private
Pump Make		Model		Serial #	Repair System Description: Conventional				☐ Other	No. Employees		☐ Public
# Nitrification Fields	Ex.	# Lines	Existing Bed	Linear Ft: Ex.	Maintenance Agreement Required:	☐ YES	☒ NO		☐ Slab	☒ Crawl Space		☐ Community
Trench Width	Ex.	Max. Trench Bottom Depth	Ex.	Gravel Depth Ex.	☒ GRAVITY	☐ PRESSURE			☐ Basement w/plumbing	☐ Basement w/o plumbing		


Comments / Conditions: System Appeared To Be Functioning @ Time of Inspection
Maintain 25' From Well With Proposed Garage

INITIAL SITE SKETCH

1" = 40'

Linwood Rd.

AS BUILT SKETCH

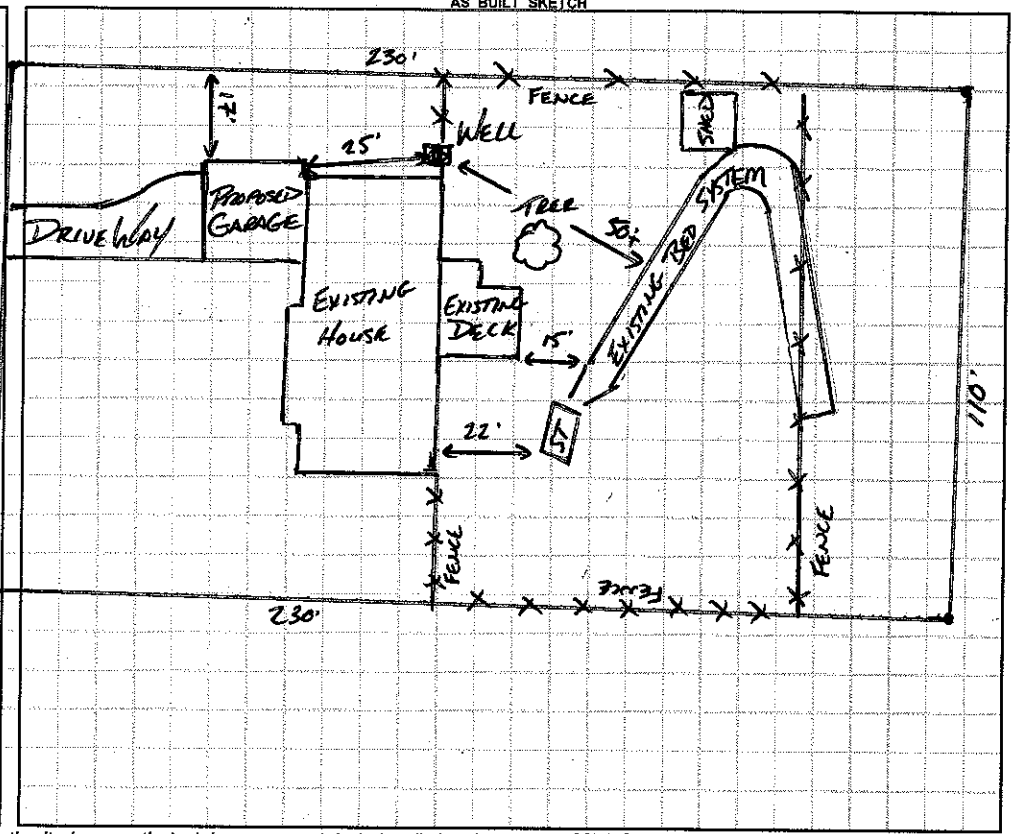

Permit can be suspended or revoked if any false information is supplied toward securing the permit / any unauthorized changes are made to the site / any unauthorized changes are made in the installation of the system. **CONTACT A LOCATOR SERVICE PRIOR TO ANY EXCAVATION**

☐ **IMPROVEMENT PERMIT** *with plat valid without expiration.* ☐ **IMPROVEMENT PERMIT** *with site plan valid for 60 mos.* ☐ **AUTHORIZATION TO CONSTRUCT** *valid for period equal to IMPROVEMENT PERMIT--not to exceed 60 mo.*

Owner / Applicant Signature: Date: 9-16-15 Installed by:

IMPROVEMENT PERMIT by: Date: OPERATION PERMIT by: Date:

AUTHORIZATION TO CONSTRUCT by: Date: Existing System Inspected by: Date: APPROVED SEP 14 2015

Health Dept. Copy - WHITE Applicant (Final Approval) - YELLOW Applicant (Conditional Approval) - PINK