IREDELL COUNTY HEALTH DEPARTMENT

STATESVILLE 704-878-5305 4676342731 MOORESVILLE 704-664-5281

IMPROVEMENT PERMIT / CERTIFICATE OF COMPLETION / OPERATION PERMIT / EXISTING SYSTEM INSPECTION

PROPERTY DESCRIPTION NO. 17121 DATE 10/6/93

OWNER OR CONTRACTOR BRADLEY BRAWLEY PHONE: Business _____ TAX MAP NO. 1H A 121

ADDRESS Rt 10 Box 850 MOORESVILLE, NC. Home 664-2457 ~~4676-42-3195~~

LOCATION QUAIL RUN. TL LAST PAVED ROAD BEFORE SOUTH IREDELL FIRE DEPT, TOWARDS CNTL

SUBDIVISION QUAIL RUN BLOCK / SECTION — LOT ~~WAY~~ 4 LOT AREA 4.5 AC. SITE CLASS. P. L.T.A.R. .2-.25

Water Supply: ☑ Individual ☐ Community ☐ Public

Septic Tank: 1000 Gallons; STB 794 Date 11-7-95

Pump Tank: _____ Gallons; PT _____ Date _____

Nitrification Field: No Fields 1 Square Feet 1440 Linear Feet 576

No Lines 8 Trench Width 2.0' Trench Depth 20" Gravel Depth No

☑ New System ☐ Repair System Type: I, II, III, IV, V, VI

System Description: 10" FIBERWRAP PIPE

Repair System Description: SAME 9-35

Maintenance Agreement Required: ☐ Yes ☑ No

☑ House/Mod. Home ☐ Mobile Home ☐ Business ☐ Other _____

No. Bedrooms 3 No. Bathrooms 2 No. Employees _____

☐ Slab ☑ Crawl Space ☐ Basement w/plumbing ☐ Basement wo/plumbing

Garbage Disposal: ☐ Yes ☑ No

Auto. Dishwasher: ☑ Yes ☐ No


Auto. Washing Machine: ☑ Yes ☐ No

Other _____

Comments

10" FIBERWRAP PIPE DRAINFIELD.
20-22" TRENCH DEPTH MAXIMUM
COVER REQUIRED FOR 6" UNIFORM COVER
DROP BOXES - MUST FOLLOW CONTOURS

INITIAL SITE SKETCH

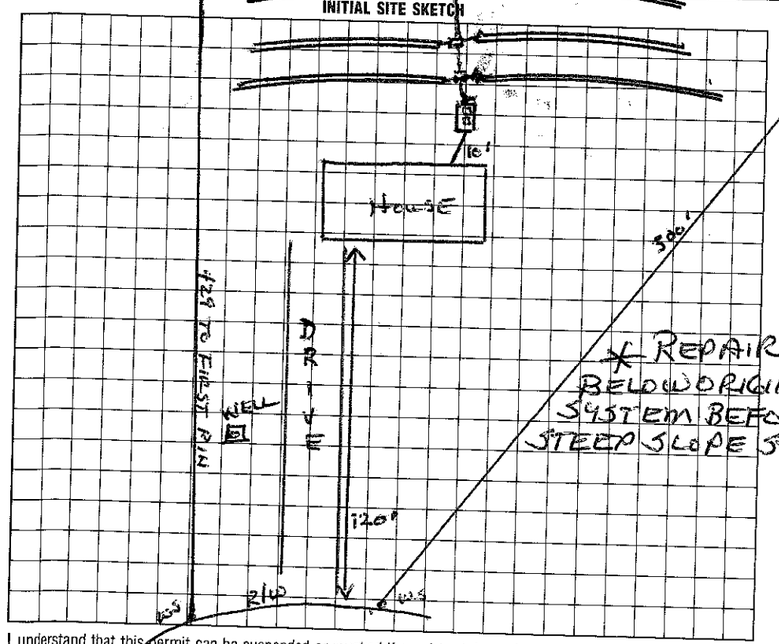

AS BUILT SKETCH

1/23/96 - Both Homes 2 lines checked -

I understand that this permit can be suspended or revoked if any false information is supplied toward securing the permit/any unauthorized changes are made to the site/any unauthorized changes are made in the installation of the system. Improvement Permit is valid for 60 months from date of issuance.

Signed: Bradley K Brawley ~~CALOSAC~~

Improvement Permit by: Wesley Sparks R.S. date 10/6/93

Existing System Inspection by: _____ date _____

Installed by: Lamp Timber

Certificate of Completion by: Wesley Sparks R.S. date 1/25/96

Operation Permit by: Wesley Sparks R.S. date 1/25/96

HEALTH DEPT. COPY: WHITE INSPECTION COPY (FINAL): GREEN OWNER COPY (FINAL): YELLOW INSPECTION COPY (INITIAL): PINK OWNER COPY (INITIAL): GOLD