IREDELL COUNTY HEALTH DEPARTMENT

STATESVILLE 704-878-5305 MOORESVILLE 704-664-5281

IMPROVEMENT PERMIT / AUTHORIZATION TO CONSTRUCT / OPERATION PERMIT / EXISTING SYSTEM INSPECTION

PERMIT# 150524 PIN# 4676352527 DATE 6/16/08

OWNER OR APPLICANT Michael Clark / CMH Homes Inc. PHONE: Business 704.660.8327 Home

ADDRESS 162 Woodwind Dr. Mooresville, NC

LOCATION Hwy 152 E, TR Linwood, TL Brumley, TR Woodwind, on Rt

SUBDIVISION Quail Hill BLOCK / SECTION — LOT 82 LOT AREA 0.65 acres SITE CLASS. P.S. DESIGN FLOW 360 L.T.A.R. 0.3

Septic Tank: existing Gallons: STB Date

Pump Tank: Gallons: PT Date

Pump Make: Model Serial No.

Nitrification Field: No Fields 1 Square Feet 900 Linear Feet 300

No Lines 3 Trench Width 36" Max Trench Bottom Depth 36"

☐ New System ☐ Repair ☐ Expansion System Type: I II III IV V VI

System Description: existing grav. conv.

Repair System Description: 25% reduction

Maintenance Agreement Required: ☐ Yes ☒ No

☐ House/Mod. Home ☑ Mobile Home ☐ Business ☐ Other

No. Bedrooms 3 No. Persons No. Employees


Water Supply: ☑ Individual ☐ Public ☐ Community

Gravel Depth 12" ☑ Gravity ☐ Pressure ☐ Slab ☐ Crawl Space ☐ Basement w/plumbing ☐ Basement wo/plumbing

Comments:/Conditions: - 3" @ 100' lines in front yard
- System is functioning properly for current 3 bd.

Comments:/Conditions:

INITIAL SITE SKETCH

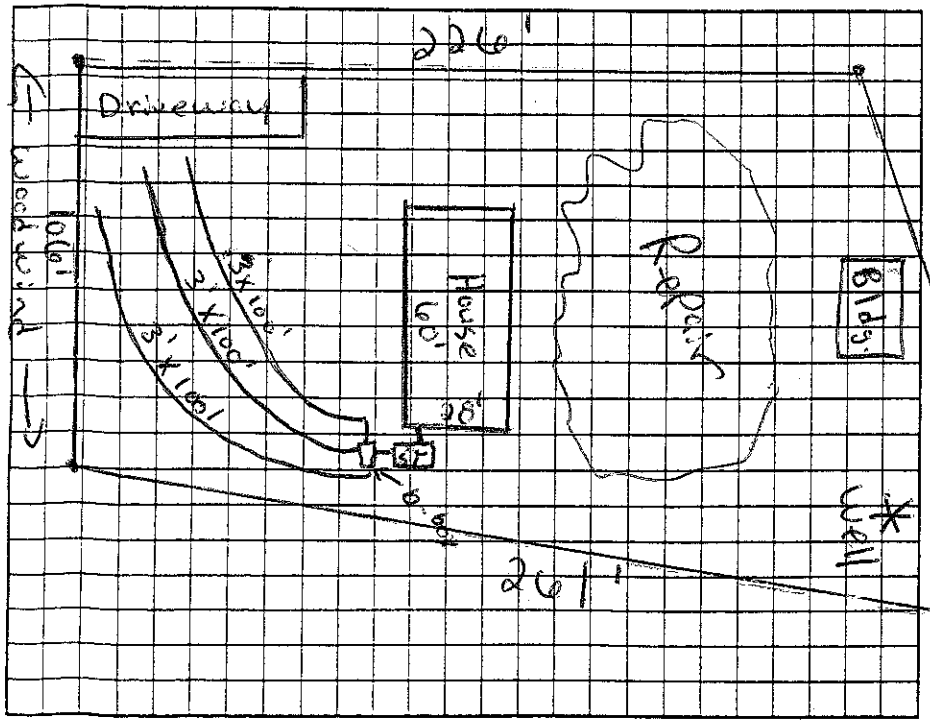

AS BUILT SKETCH

Permit can be suspended or revoked if any false information is supplied toward securing the permit/any unauthorized changes are made to the site/any unauthorized changes are made in the installation of the system. Improvement Permit with plat valid without expiration ☐ Improvement Permit with site plan valid for sixty months ☐ Authorization to Construct is valid for a period equal to that of Improvement Permit – not to exceed sixty months.

Signed: Eric McWard date 6-4-08 Installed by:

Improvement Permit by: date Operation Permit by: date

Authorization to Construct by: date Existing System Inspection by: Lawrence date 6/6/08

HEALTH DEPT. COPY: WHITE OWNER COPY (FINAL): YELLOW OWNER COPY (INITIAL): PINK