IREDELL COUNTY HEALTH DEPARTMENT

Statesville Office (704) 878-5305 Mooresville Office (704) 660-3625 PERMIT # 205819

IMPROVEMENT PERMIT / AUTHORIZATION TO CONSTRUCT / OPERATION PERMIT / EXISTING SYSTEM

PIN # 4676-35-6833

APPLICANT: Dean Sloan APPLICANT ADDRESS: PO Box 1653 Mooresville NC 28115

SITE ADDRESS: 183 Woodwinds Drive PHONE: (704) 664 1847 ALT. PHONE:

SITE DIRECTIONS: Go main St N (152) TR on Linwood TL on Brumley TR on Woodwinds Dr.

SUBDIVISION: Quail Hill SECTION: LOT # 44 LOT AREA: DESIGN FLOW: 240 L.T.A.R.: N/A

Septic Tank 1000 (gal) STB Date
Pump Tank (gal) PT Date
Pump Make Model Serial #
Nitrification Fields 1 # Lines (2) 110' each Linear Ft: 240'
Trench Width 36" Max. Trench Bottom Depth 24" Gravel Depth 12"


☐ New System ☐ Repair ☐ Expansion System Type: (II) III IV V VI
System Description: two conventional 110' lines
Repair System Description: pre 83
Maintenance Agreement Required: ☐ YES ☑ NO
☑ GRAVITY ☐ PRESSURE

☑ Residence ☐ Business ☐ Other ☐ Slab ☐ Basement w/plumbing
No. Bedrooms 2 No. Persons No. Employees ☑ Crawl Space ☐ Basement w/o plumbing


Water Supply: ☑ Private well ☐ Public ☐ Community

Comments / Conditions: This is an existing system reuse permit for the existing 2 BR system. Remove existing mobile home and replace with 2 BR modular home. No increase in BR's or water useage (240 gpd max). No alteration to existing system needed

INITIAL SITE SKETCH

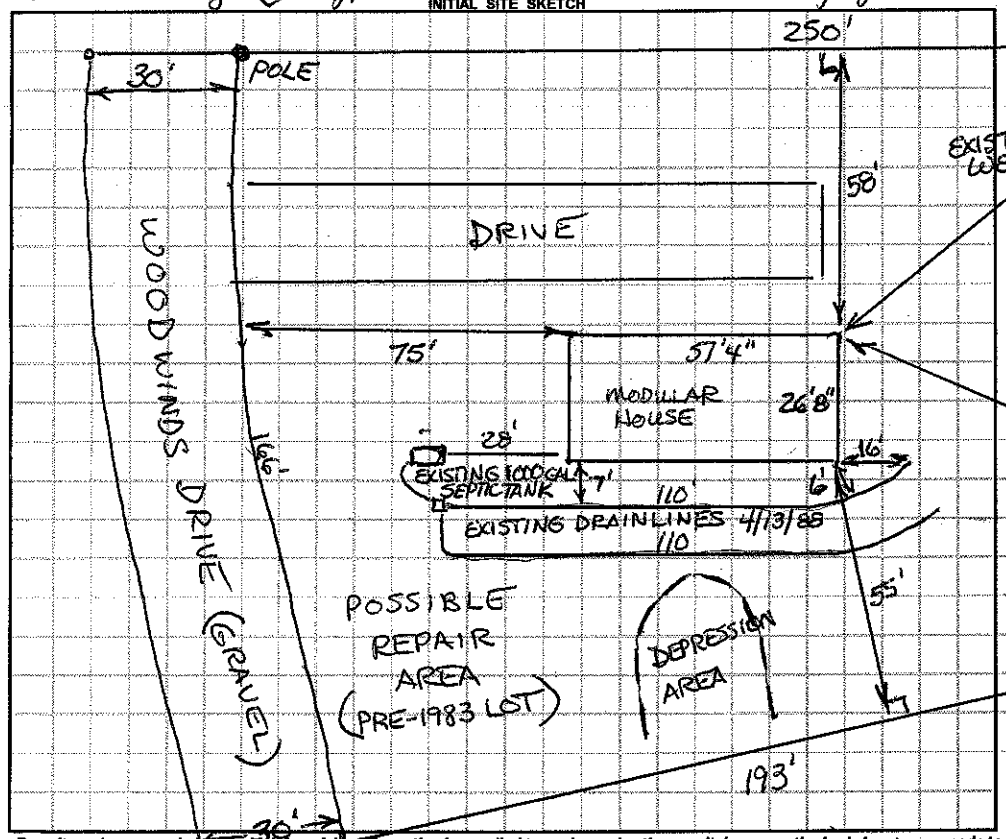

AS BUILT SKETCH

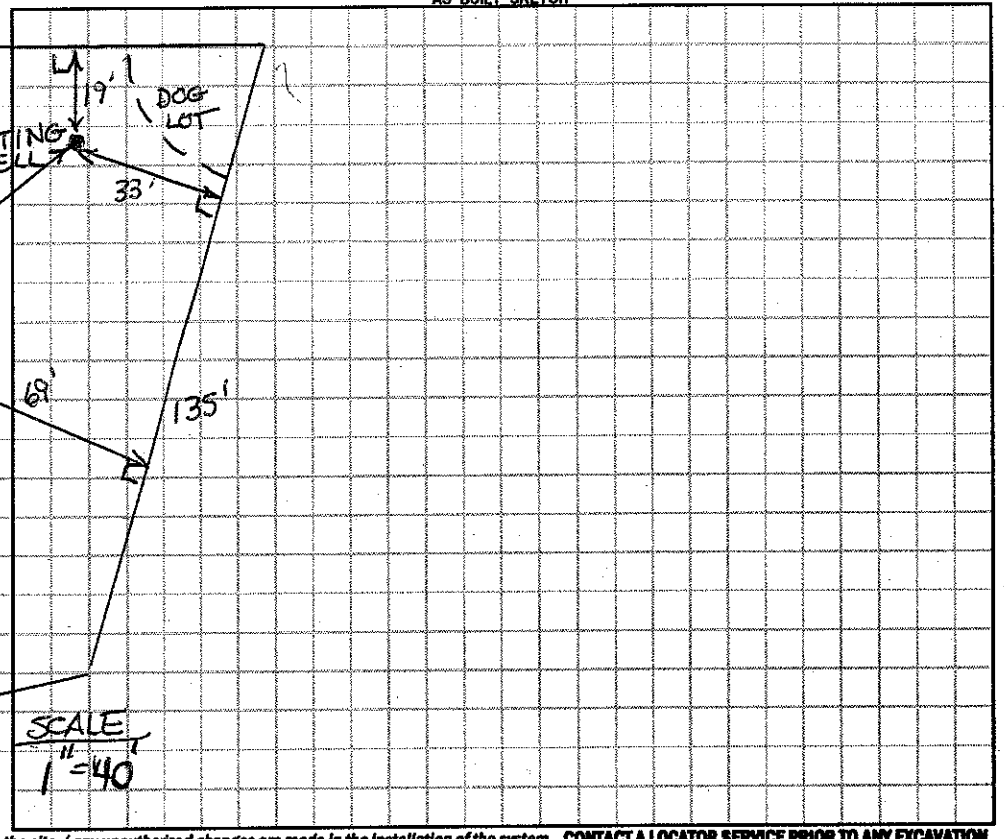

Permit can be suspended or revoked if any false information is supplied toward securing the permit / any unauthorized changes are made to the site / any unauthorized changes are made in the installation of the system. **CONTACT A LOCATOR SERVICE PRIOR TO ANY EXCAVATION**

☐ **IMPROVEMENT PERMIT with plat** *valid without expiration.* ☐ **IMPROVEMENT PERMIT with site plan** *valid for 60 mos.* ☐ **AUTHORIZATION TO CONSTRUCT** *valid for period equal to IMPROVEMENT PERMIT--not to exceed 60 mo.*

Owner / Applicant Signature: 10/7/14

IMPROVEMENT PERMIT by: Date:

AUTHORIZATION TO CONSTRUCT by: Date:

Location of the proposed existing system reuse addition does not appear to impact the existing on-site septic system or well.**NOTE: changing 2BR mobile home for 2BR modular home REHS Date: 10/7/14

ICHD-Environmental Health Division

Richard Harris

PINK