IREDELL COUNTY HEALTH DEPARTMENT

STATESVILLE 704-878-5305 MOORESVILLE ~~704-664-5281~~

IMPROVEMENT PERMIT / CERTIFICATE OF COMPLETION / OPERATION PERMIT / EXISTING SYSTEM INSPECTION

PROPERTY DESCRIPTION NO. 66217 DATE 5/2/97 TAX MAP NO. ~~10~~ ~~7770~~ 46763691 99 Watershed: ☐ Yes ☐ No

OWNER OR CONTRACTOR Mark & Sandra Keller PHONE: Business (704) 664-6485 Home

ADDRESS 105 Lake Haven Ln. Mooresville, NC

LOCATION Linwood TR on Brumley TR on Woodwind at end of rd TL (Lake Haven); Corner of Oakbrook Lk. Haven

SUBDIVISION Quail Hill BLOCK / SECTION J LOT 52-B LOT AREA SITE CLASS. P.S DESIGN FLOW 360 gpd L.T.A.R.

Septic Tank: 1600 Gallons; STB Date

Pump Tank: Gallons; PT Date

Pump Make: EXISTING Model Serial No.

Nitrification Field: No Fields Square Feet 900 Linear Feet 100'

No Lines 3 Trench Width 3' Max Trench Bottom Depth Gravel Depth

☒ New System ☐ Repair System Type: I, II, III, IV, V, VI

System Description: Gravity Conventional

Repair System Description:

Maintenance Agreement Required: ☐ Yes ☐ No

☒ House/Mod. Home No. Bedrooms 3

☒ Mobile Home No. Bathrooms

☐ Business No. Employees

☐ Other

☐ Slab ☐ Crawl Space ☐ Basement w/plumbing ☐ Basement wo/plumbing


Water Supply:
☒ Individual
☐ Community
☐ Public

Comments: Septic System operating well at time of inspection, No sign of malfunctions System sized for 3 Bdrms at time of original permit.

Comments:

Not to Scale

INITIAL SITE SKETCH

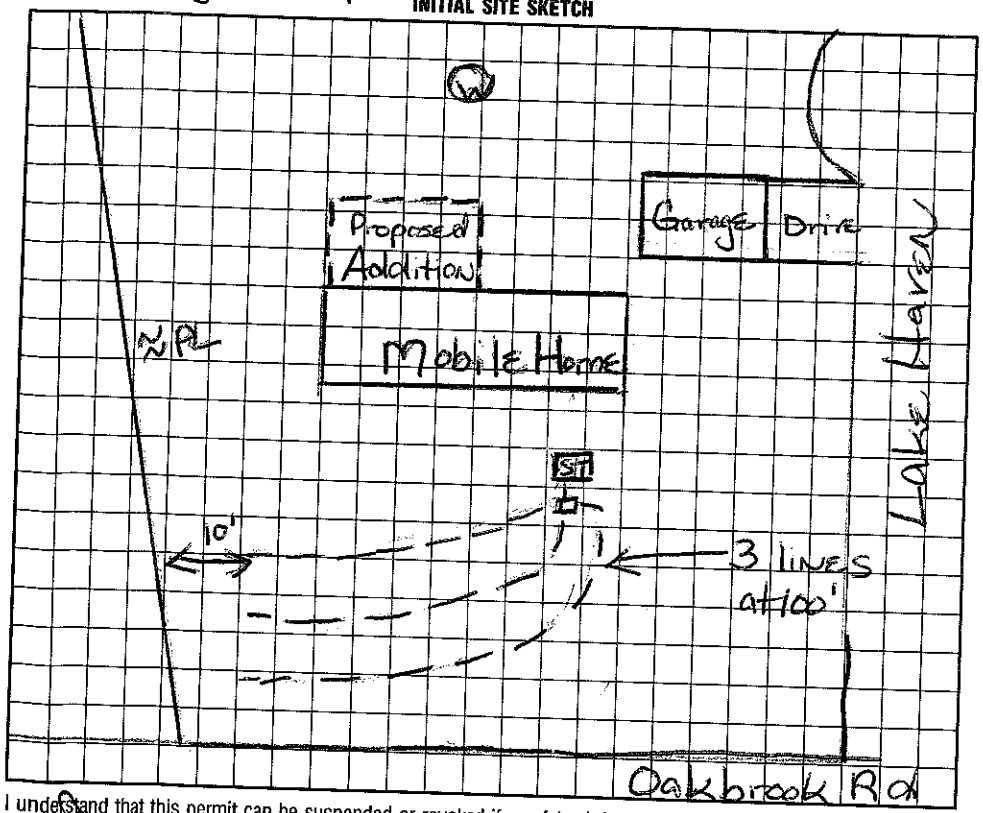

AS BUILT SKETCH

I understand that this permit can be suspended or revoked if any false information is supplied toward securing the permit/any unauthorized changes are made to the site/any unauthorized changes are made in the installation of the system. Improvement Permit is valid for 60 months from date of issuance.

Signed: Sandra M. Keller

Improvement Permit by: date

Existing System Inspection by: Maria Dolson date 5/2/97

Installed by:

Certificate of Completion by: date

Operation Permit by: date

HEALTH DEPT. COPY: WHITE INSPECTION COPY (FINAL): GREEN OWNER COPY (FINAL): YELLOW INSPECTION COPY (INITIAL): PINK OWNER COPY (INITIAL): GOLD