IREDELL COUNTY HEALTH DEPARTMENT

STATESVILLE 704-878-5305 MOORESVILLE 704-664-5281

IMPROVEMENT PERMIT / AUTHORIZATION TO CONSTRUCT / OPERATION PERMIT / EXISTING SYSTEM INSPECTION

PERMIT# 20926 PIN# 1H-12-A-55 4676-36-9068 DATE 4/6/99

OWNER OR CONTRACTOR Lisa R. Cook PHONE: Business Home 663-5961

ADDRESS 141 Oakbrook Dr. Mooresville, NC. 28115

LOCATION Quail Hill; Lynwood Rd TL on Brumley TR Woodwinds to stop sign TL on Oakbrook on (R) at Lakehaven Dr.

SUBDIVISION Quail Hill BLOCK / SECTION 3+4 LOT 55 LOT AREA ~ 1 AC SITE CLASS PS DESIGN FLOW 360 L.T.A.R. .3

Septic Tank: 1000 Gallons; STB 760 Date 12/13/98

Pump Tank: Gallons; PT Date

Pump Make: Model Serial No.

Nitrification Field: No Fields 1 Square Feet 900 ± Linear Feet 300 ±

No Lines ~~4 @ 75'~~ 3 @ 100' Trench Width 3' Max Trench Bottom Depth 3'

Gravel Depth SAND.

(X) New System ( ) Repair System Type: I, II, (III) IV, V, VI

System Description: GRAVITY - TYPE III DRAINFIELD

Repair System Description: SAME

Maintenance Agreement Required: ( ) Yes (X) No

( ) House/Mod. Home (X) Mobile Home ( ) Business ( ) Other

No. Bedrooms 3 No. Bathrooms 2 No. Employees

( ) Slab (X) Crawl Space ( ) Basement w/plumbing ( ) Basement wo/plumbing

Water Supply: (X) Individual ( ) Public ( ) Community


Comments/Conditions: ± 25% reduction given for HDS or CH Plastic

install wheels shown here.


Comments/Conditions:

LAKEHAVEN LANE

INITIAL SITE SKETCH

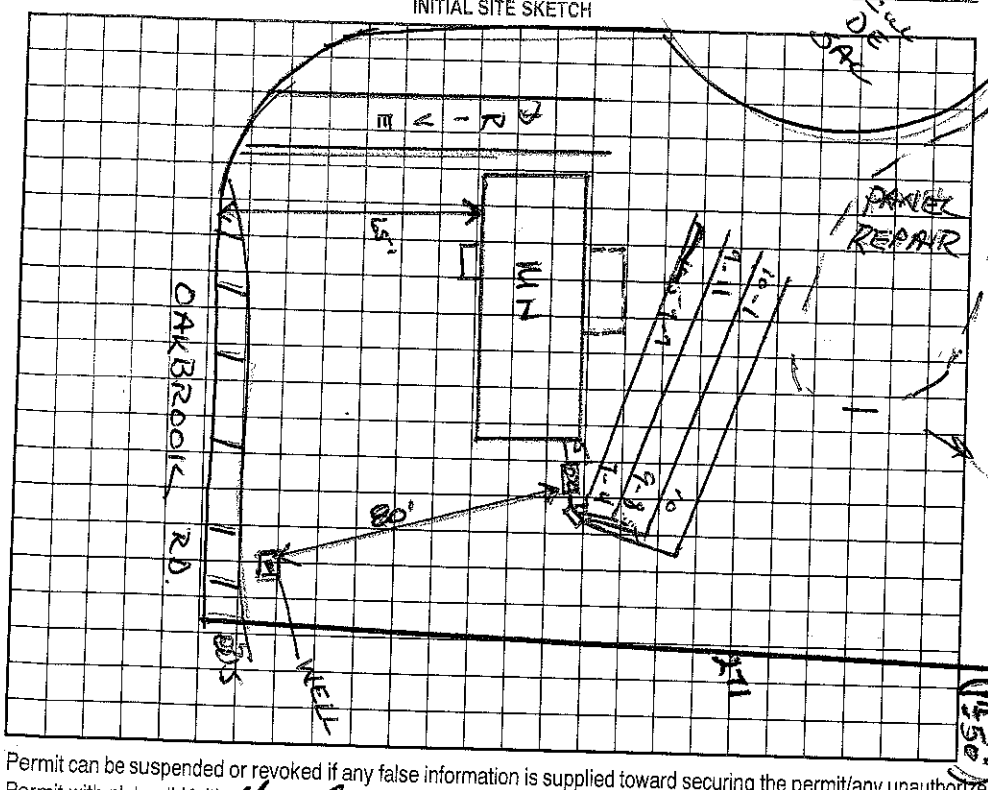

AS BUILT SKETCH

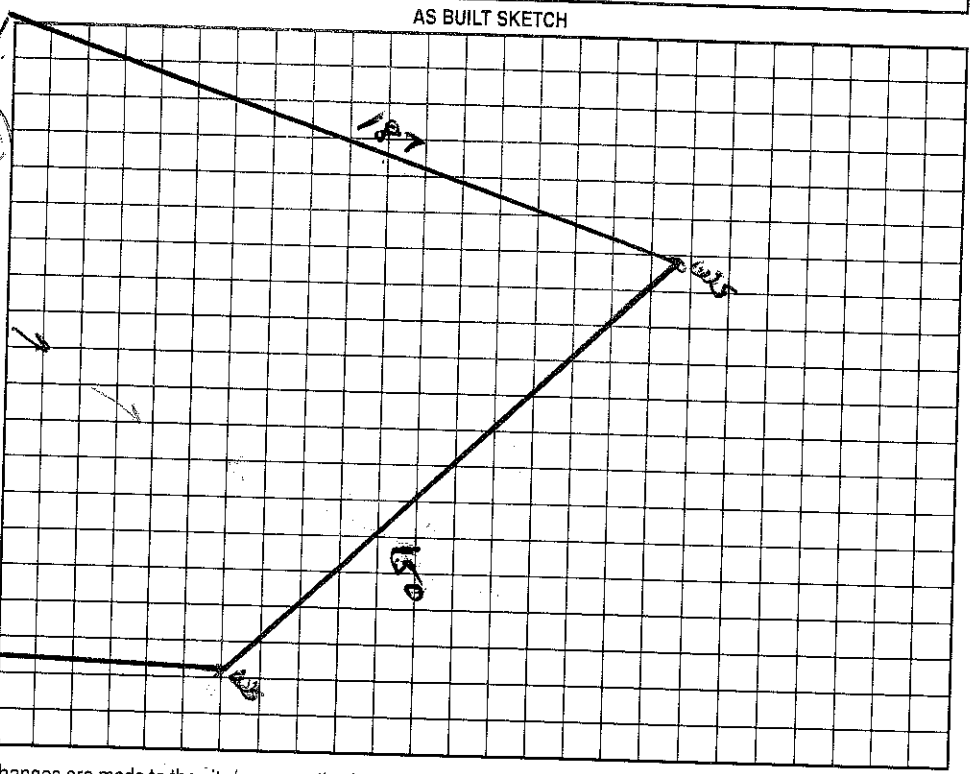

Permit can be suspended or revoked if any false information is supplied toward securing the permit/any unauthorized changes are made to the site/any unauthorized changes are made in the installation of the system. Improvement Permit with plat valid without expiration. Improvement Permit with site plan valid for sixty months. Authorization to Construct is valid for a period equal to that of Improvement Permit – not to exceed sixty months.

Signed: Billy [illegible] date 4/7/99 Installed by: K+L Backhoe

Improvement Permit by: Wesley Sparks R.S. date 4/6/99 Operation Permit by: Wesley Sparks R.S. date 4/14/99

Authorization to Construct by: Wesley Sparks R.S. date 4/6/99 Existing System Inspection by: date

HEALTH DEPT. COPY: WHITE OWNER COPY (FINAL): YELLOW OWNER COPY (INITIAL): PINK