IREDELL COUNTY HEALTH DEPARTMENT

STATESVILLE 704-878-5305 MOORESVILLE 704-664-5281

IMPROVEMENT PERMIT / CERTIFICATE OF COMPLETION / OPERATION PERMIT / EXISTING SYSTEM INSPECTION

PROPERTY DESCRIPTION NO. 17320 DATE 11/9/93 TAX MAP NO. 1H-11-A-7 Watershed: ☑ Yes ☐ No

OWNER OR CONTRACTOR LARRY FREEZE PHONE: Business Home 528-9556

ADDRESS Rt 2 Box 326 CLEVELAND, NC. 27013 4676-37-4184

LOCATION L CORNER OF QUAIL HILL RD AND BRUMLEY

SUBDIVISION QUAIL HILL BLOCK / SECTION LOT 9 LOT AREA ~1.0 SITE CLASS. P DESIGN FLOW 360 L.T.A.R. .3

Septic Tank: 1000 Gallons; STB Date

Pump Tank: Gallons; PT Date

Pump Make: Model Serial No.

Nitrification Field: No Fields 1 Square Feet 1200 Linear Feet 400

No Lines 5 Trench Width 3' Max Trench Bottom Depth 30" Gravel Depth 12"

☑ New System ☐ Repair System Type: I (II) III, IV, V, VI

System Description: CONV - DIST BOX

Repair System Description: " "

Maintenance Agreement Required: ☐ Yes ☐ No

☐ House/Mod. Home No. Bedrooms 3

☑ Mobile Home No. Bathrooms 2

☐ Business No. Employees

☐ Other


☐ Slab ☑ Crawl Space ☐ Basement w/plumbing ☐ Basement wo/plumbing

Water Supply: ☑ Individual ☐ Community ☐ Public EXISTING

Comments:

Comments: I checked only the D-box and approx last 30' of lowest trench D.R. Hinson The remainder of the system was inspected by Wesley Sparks and according to a phone conversation w/ him was OK. DRH

INITIAL SITE SKETCH

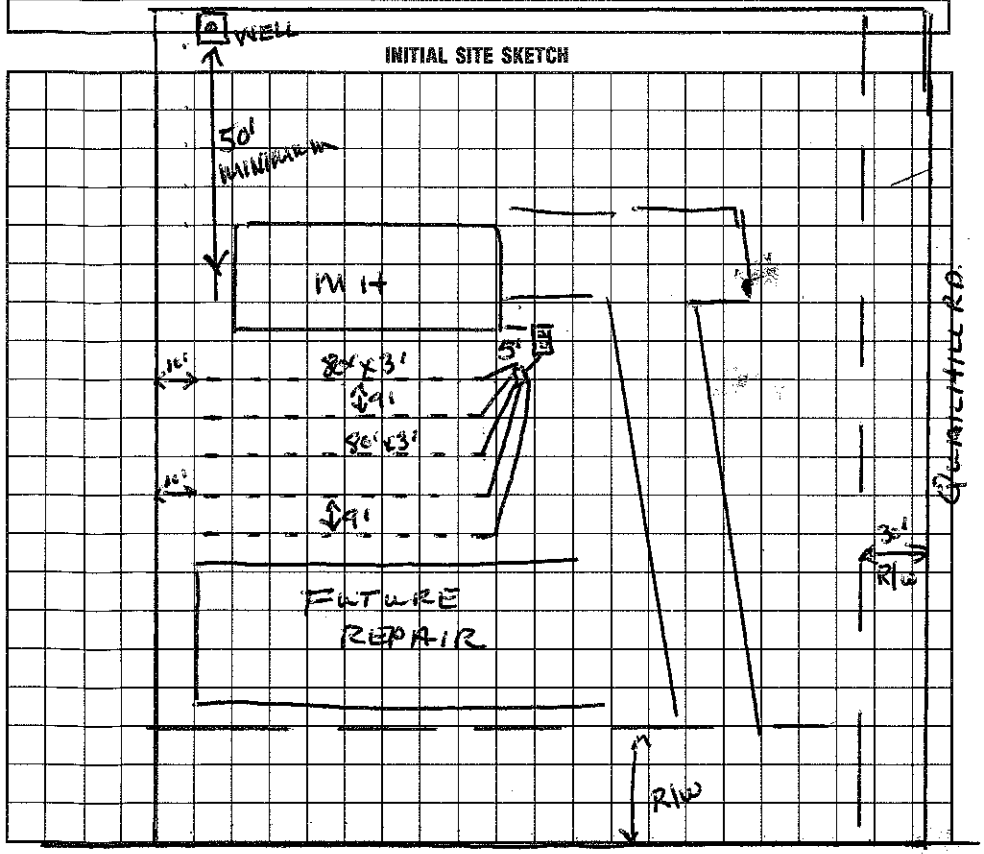

AS BUILT SKETCH

I understand that this permit can be suspended or revoked if any false information is supplied toward securing the permit/any unauthorized changes are made to the site/any unauthorized changes are made in the installation of the system. Improvement Permit is valid for 60 months from date of issuance. BRUMLEY RD.

Signed: Larry Freeze

Improvement Permit by: Wesley Sparks R.S. date 11/9/93

Existing System Inspection by: date

Installed by: AJ Ervin

Certificate of Completion by: David R. Hinson, R.S. date 12-3-93

Operation Permit by: date

HEALTH DEPT. COPY: WHITE INSPECTION COPY (FINAL): GREEN OWNER COPY (FINAL): YELLOW INSPECTION COPY (INITIAL): PINK OWNER COPY (INITIAL): GOLD