IREDELL COUNTY HEALTH DEPARTMENT

4676376222

STATESVILLE 704-878-5305 MOORESVILLE 704-664-5281

IMPROVEMENT PERMIT / AUTHORIZATION TO CONSTRUCT / OPERATION PERMIT / EXISTING SYSTEM INSPECTION

PERMIT# 4901 MOORESVILLE PIN# 4677344297

OWNER OR CONTRACTOR PHONGPOSITA INSIXIANGNAY PHONE: Business _____ Home 664-2006 DATE 9/9/98

ADDRESS 571 BRAMLEY LO - MOORESVILLE NC 28115

LOCATION 150/152 TR ALEXANDER ACRES - ON RT

SUBDIVISION _____ BLOCK / SECTION _____ LOT _____ LOT AREA 2AC SITE CLASS. C5 DESIGN FLOW 360GPD L.T.A.R. 300/1052

Septic Tank: 1000 Gallons; STB 794 Date 9/12/98

Pump Tank: _____ Gallons; PT _____ Date _____

Pump Make: _____ Model _____ Serial No. _____

Nitrification Field: No Fields 1 Square Feet 1200 Linear Feet 400

No Lines 5@80' Trench Width 36" Max Trench Bottom Depth 36" Gravel Depth 12"

☑ New System ☐ Repair System Type: I (II) III, IV, V, VI

System Description: GRAVITY CONVENTIONAL

Repair System Description: SAME

Maintenance Agreement Required: ☐ Yes ☑ No

☐ Slab ☑ Crawl Space ☐ Basement w/plumbing ☐ Basement wo/plumbing

☐ House/Mod. Home ☑ Mobile Home ☐ Business ☐ Other


No. Bedrooms 3 No. Bathrooms 2 No. Employees ____

Water Supply: ☑ Individual ☐ Public ☐ Community

Comments:/Conditions:

Comments:/Conditions:

INITIAL SITE SKETCH NO SCALE

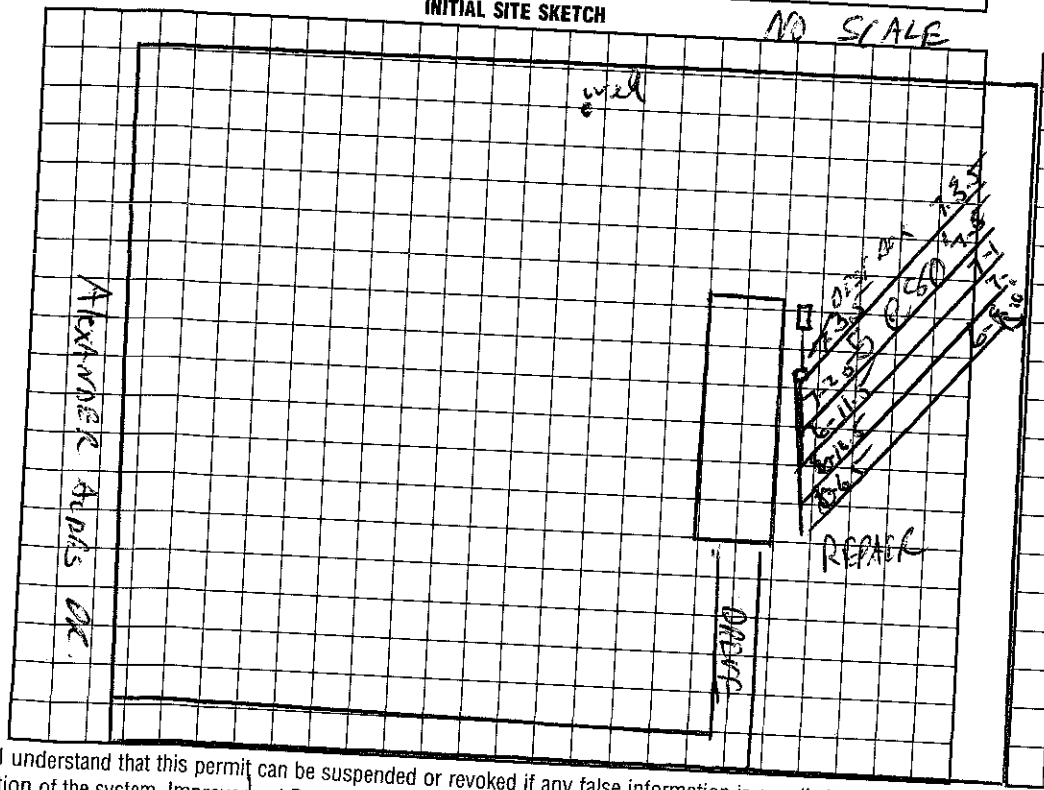

AS BUILT SKETCH

I understand that this permit can be suspended or revoked if any false information is supplied toward securing the permit/any unauthorized changes are made to the site/any unauthorized changes are made in the installation of the system. Improvement Permit with plat valid without expiration. Improvement Permit with site plan valid for sixty months. Authorization to Construct is valid for a period equal to that of Improvement Permit – not to exceed sixty months.

Signed: X _____

Improvement Permit by: _____ date 9/9/98

Authorization to Construct by: _____ date 9/9/98

Installed by: Chris Kaminska

Operation Permit by: Wesley Sparks R.S. date 10/8/98

Existing System Inspection by: _____ date _____

HEALTH DEPT. COPY: WHITE INSPECTION COPY (FINAL): GREEN OWNER COPY (FINAL): YELLOW INSPECTION COPY (INITIAL): PINK OWNER COPY (INITIAL): GOLD