IREDELL COUNTY HEALTH DEPARTMENT

→ Authorization to Construct

STATESVILLE 704-878-5305 MOORESVILLE 704-664-5281

IMPROVEMENT PERMIT / ~~CERTIFICATE OF COMPLETION~~ / OPERATION PERMIT / EXISTING SYSTEM INSPECTION

PROPERTY DESCRIPTION NO. 23772 DATE 5/29/96 TAX MAP NO. 14-10-11 & 12

OWNER OR CONTRACTOR Jeffrey & Loretta Eagle PHONE: Business _____ Home 663-7223

ADDRESS 828 Linwood Rd Mooresville NC 28115 Watershed: ☐ Yes ☒ No

LOCATION Beside #828 - 115 S - TL 152 - TR Linwood - TR Log House Rd. - 2nd & 3rd lots on rt 4616-42-0035

SUBDIVISION Quail Run #2 BLOCK / SECTION 2 LOT 11 & 12 LOT AREA _____ SITE CLASS. 15 DESIGN FLOW 360 gpd L.T.A.R. .3 gpd/ft²

Septic Tank: 1000 Gallons; STB 797 Date 10/1/96

Pump Tank: _____ Gallons; PT _____ Date _____

Pump Make: _____ Model _____ Serial No. _____

Nitrification Field: No Fields 1 Square Feet 1200 Linear Feet 400

No Lines 5 Trench Width 36" Max Trench Bottom Depth 36"

☒ New System ☐ Repair System Type: I. II. III. IV. V. VI

System Description: Gravity Conventional

Repair System Description: Same

Maintenance Agreement Required: ☐ Yes ☒ No

Gravel Depth 12"

☒ House/Mod. Home No. Bedrooms 3

☐ Mobile Home No. Bathrooms 2.5

☐ Business No. Employees ____

☐ Other _____


☐ Slab ☐ Crawl Space ☐ Basement w/plumbing ☒ Basement wo/plumbing

Water Supply: ☒ Individual ☐ Community ☐ Public

Comments:

Comments:

INITIAL SITE SKETCH

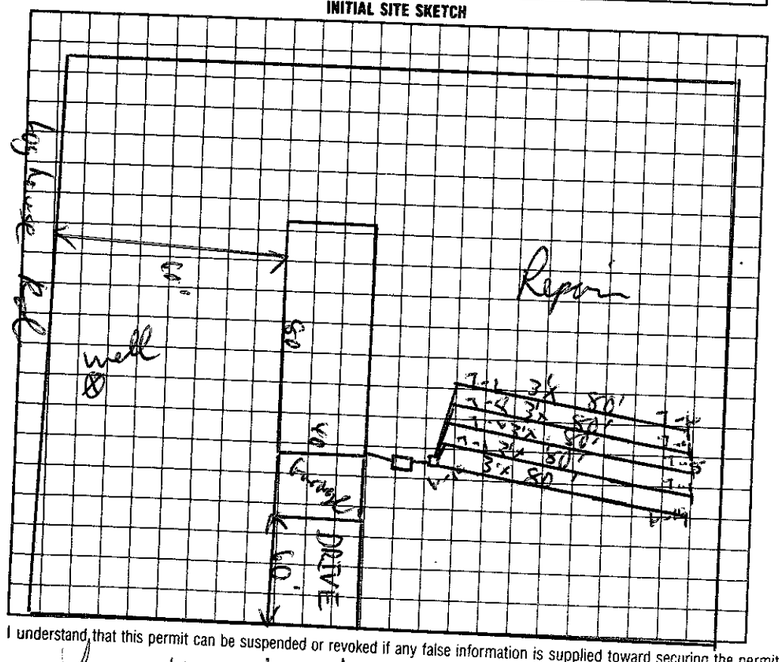

AS BUILT SKETCH

I understand that this permit can be suspended or revoked if any false information is supplied toward securing the permit/any unauthorized changes are made to the site/any unauthorized changes are made in the installation of the system.

Signed: Loretta J. Eagle

Improvement Permit by: C. Ray Freeman EHSI date 5/29/96

Existing System Inspection by: C. Ray Freeman EHSI date 5/29/96

Authorization to Construct

Installed by: Wayne Ordison

Certificate of Completion by: _____ date _____

Operation Permit by: Wesley Sparks E.S. date 12/4/96

HEALTH DEPT. COPY: WHITE INSPECTION COPY (FINAL): GREEN OWNER COPY (FINAL): YELLOW INSPECTION COPY (INITIAL): PINK OWNER COPY (INITIAL): GOLD

Authorization to Construct is valid for 60 months from issue date