IMPROVEMENT PERMIT / AUTHORIZATION TO CONSTRUCT / OPERATION PERMIT / EXISTING SYSTEM INSPECTION

PERMIT# 071581 PIN# 4676423195 DATE 1/26/98

OWNER OR CONTRACTOR Roger Mincy PHONE: Business Home 855-5394

ADDRESS 415 Gray Lane Mooresville, NC. 28115

LOCATION on (L) at intersection of Linwood & Teeter Rds.

SUBDIVISION Quail Run BLOCK / SECTION 2 LOT 4 LOT AREA ~.6Ac SITE CLASS PS DESIGN FLOW 360 L.T.A.R. .3

Septic Tank: 1000 Gallons; STB 821 Date 6/8/98
Pump Tank: ____ Gallons; PT ____ Date ____
Pump Make: ____ Model ____ Serial No. ____
Nitrification Field: No Fields 1 Square Feet 900 Linear Feet 300
Lines 4 Trench Width 36" Max Trench Bottom Depth 36 Gravel Depth SAND

[X] New System [ ] Repair System Type: I, II, (III) IV, V, VI
System Description: GRAV - CH PLASTIC
Repair System Description: GRAV - PANEL
Maintenance Agreement Required: [ ] Yes [X] No

[X] House/Mod. Home No. Bedrooms 3
[ ] Mobile Home No. Bathrooms 2
[ ] Business No. Employees ____
[ ] Other ____


[ ] Slab [X] Crawl Space [ ] Basement w/plumbing [ ] Basement wo/plumbing

Water Supply: [X] Individual [ ] Public [ ] Community

Conditions:

Comments:/Conditions:

INITIAL SITE SKETCH

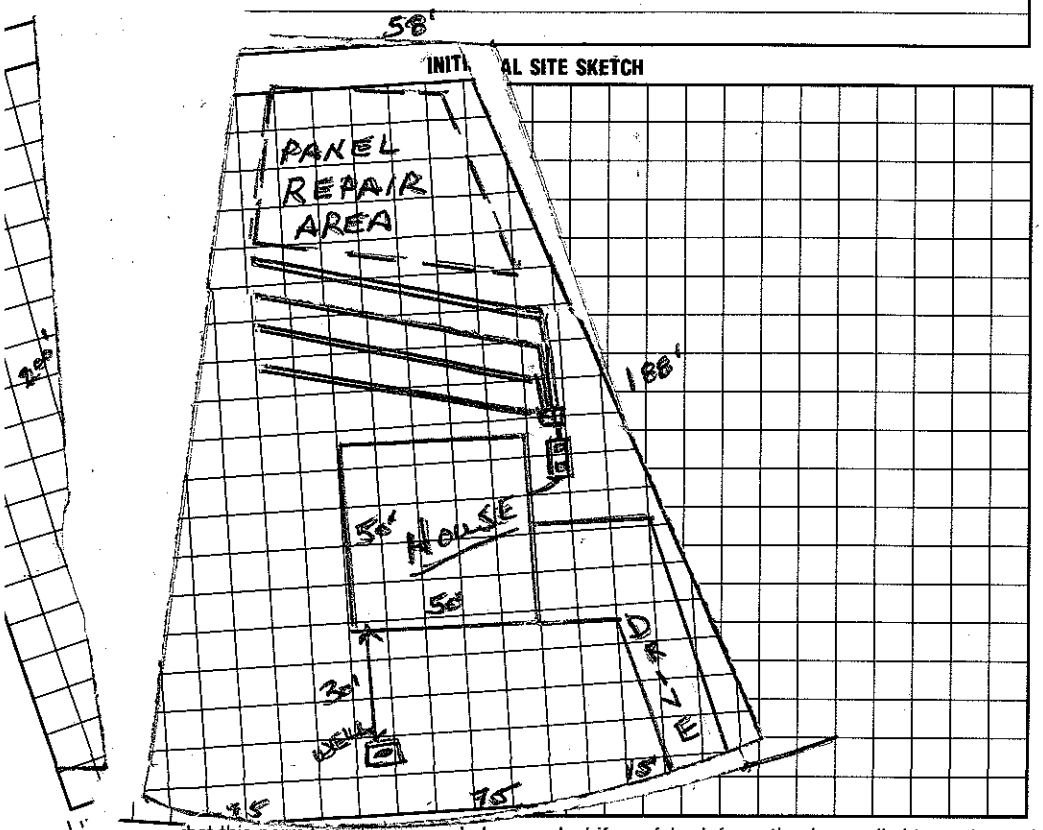

AS BUILT SKETCH

I understand that this permit can be suspended or revoked if any false information is supplied toward securing the permit/any unauthorized changes are made to the site/any unauthorized changes are made in the installation of the system. Improvement Permit with plat valid without expiration. Improvement Permit with site plan valid for sixty months. Authorization to Construct is valid for a period equal to that of Improvement Permit – not to exceed sixty months.

LINWOOD RD.

Signed: Roger L. Mincy date 1-27-98 Installed by: Propst Landscaping / Dallas

Improvement Permit by: Wesley Sparks RS. date 1/26/98 Operation Permit by: Wesley Sparks RS. date 8/11/98

Authorization to Construct by: Wesley Sparks RS. date 1/26/98 Existing System Inspection by: ____ date ____

HEALTH DEPT. COPY: WHITE INSPECTION COPY (FINAL): GREEN OWNER COPY (FINAL): YELLOW INSPECTION COPY (INITIAL): PINK OWNER COPY (INITIAL): GOLD