IREDELL COUNTY HEALTH DEPARTMENT

STATESVILLE 704-878-5305 MOORESVILLE 704-664-5281

IMPROVEMENT PERMIT / AUTHORIZATION TO CONSTRUCT / OPERATION PERMIT / EXISTING SYSTEM INSPECTION

PERMIT# 106431 PIN# ~~4676-43-5557~~ 4670436253 DATE 5/30/02

OWNER OR CONTRACTOR Rachel Kimrey PHONE: Business Home 704-664-9412

ADDRESS 748 Teeter Rd. / Mooresville NC 28115

LOCATION Linwood, TL Teeter, on Lt before #748

SUBDIVISION BLOCK / SECTION LOT LOT AREA SITE CLASS. PS DESIGN FLOW 360 L.T.A.R. 0.5

Septic Tank: 1000 Gallons; STB 312 Date 9/26/01

Pump Tank: Gallons; PT Date

Pump Make: Model Serial No.

Nitrification Field: No Fields 1 Square Feet 1200 Linear Feet 400

No Lines 4 @ 100' Trench Width 36" Max Trench Bottom Depth 36" Gravel Depth 12"

☒ New System ☐ Repair System Type: I, II, III, IV, V, VI

System Description: Gravity Conventional

Repair System Description: Same

Maintenance Agreement Required: ☐ Yes ☒ No

☐ House/Mod. Home No. Bedrooms 3

☒ Mobile Home No. Bathrooms 2

☐ Business No. Employees

☐ Other


☐ Slab ☒ Crawl Space ☐ Basement w/plumbing ☐ Basement wo/plumbing

Water Supply: ☒ Individual ☐ Public ☐ Community

Comments:/Conditions:

Comments:/Conditions:

INITIAL SITE SKETCH

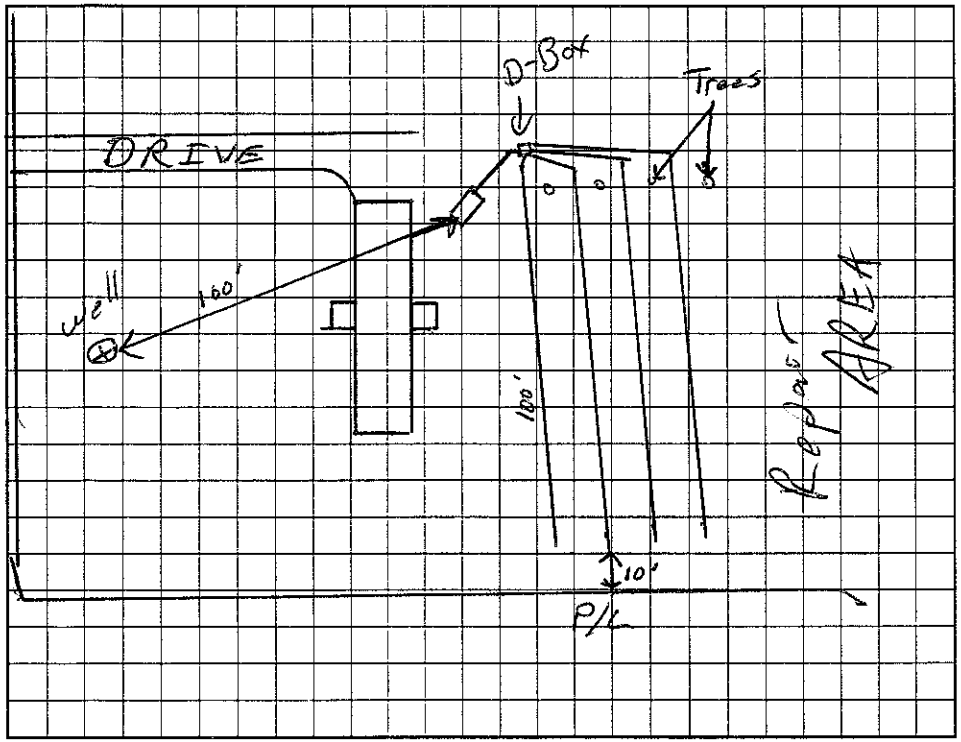

AS BUILT SKETCH

Permit can be suspended or revoked if any false information is supplied toward securing the permit/any unauthorized changes are made to the site/any unauthorized changes are made in the installation of the system. Improvement Permit with plat valid without expiration. Improvement Permit with site plan valid for sixty months. Authorization to Construct is valid for a period equal to that of Improvement Permit – not to exceed sixty months.

Signed: Larry W. Mosely date 5/31/02 Installed by: Tucker

Improvement Permit by: RS date 5/30/02 Operation Permit by: RS date 6/26/02

Authorization to Construct by: RS date 5/30/02 Existing System Inspection by: date

HEALTH DEPT. COPY: WHITE OWNER COPY (FINAL): YELLOW OWNER COPY (INITIAL): PINK