IREDELL COUNTY HEALTH DEPARTMENT

STATESVILLE 704-878-5305 MOORESVILLE 704-664-5281

IMPROVEMENT PERMIT / AUTHORIZATION TO CONSTRUCT / OPERATION PERMIT / EXISTING SYSTEM INSPECTION

PERMIT# 082756 PIN# 4676451459

OWNER OR CONTRACTOR Owens & Sandra Castle PHONE: Business 660-3017 Home DATE 7-16-99

ADDRESS 160 Oak Brook Dr Mooresville, NC 28115

LOCATION 150W TR Hwy 152 TR Brumley TL Woodwind TR Oak Brook on RT

SUBDIVISION Quail Hill BLOCK/ SECTION LOT 70 LOT AREA 2.5 Acres SITE CLASS. PS DESIGN FLOW L.T.A.R. Existing

Septic Tank: 1000 Gallons; STB Date

Pump Tank: 1000 Gallons; PT Date

Pump Make: Model Serial No.

Nitrification Field: No Fields Square Feet Linear Feet

No Lines Trench Width Existing Max Trench Bottom Depth Gravel Depth N/A

☒ New System ☐ Repair System Type: I, II, III, (IV) V, VI

System Description: Pump-LPP-Panel

Repair System Description:

Maintenance Agreement Required: ☐ Yes ☐ No Exempt

☐ House/Mod. Home ☒ Mobile Home ☐ Business ☐ Other

No. Bedrooms 3 No. Bathrooms 2 No. Employees


☐ Slab ☐ Crawl Space ☐ Basement w/plumbing ☐ Basement wo/plumbing

Water Supply: ☒ Individual ☐ Public ☐ Community

Comments/Conditions: Septic System appears to be functioning Okay at time of inspection, No problems Noticed.

Comments/Conditions: Upgrading 3 Bedroom Single Wide for 3 Bedroom Doublewide System originally installed 6/5/89

INITIAL SITE SKETCH Not to Scale

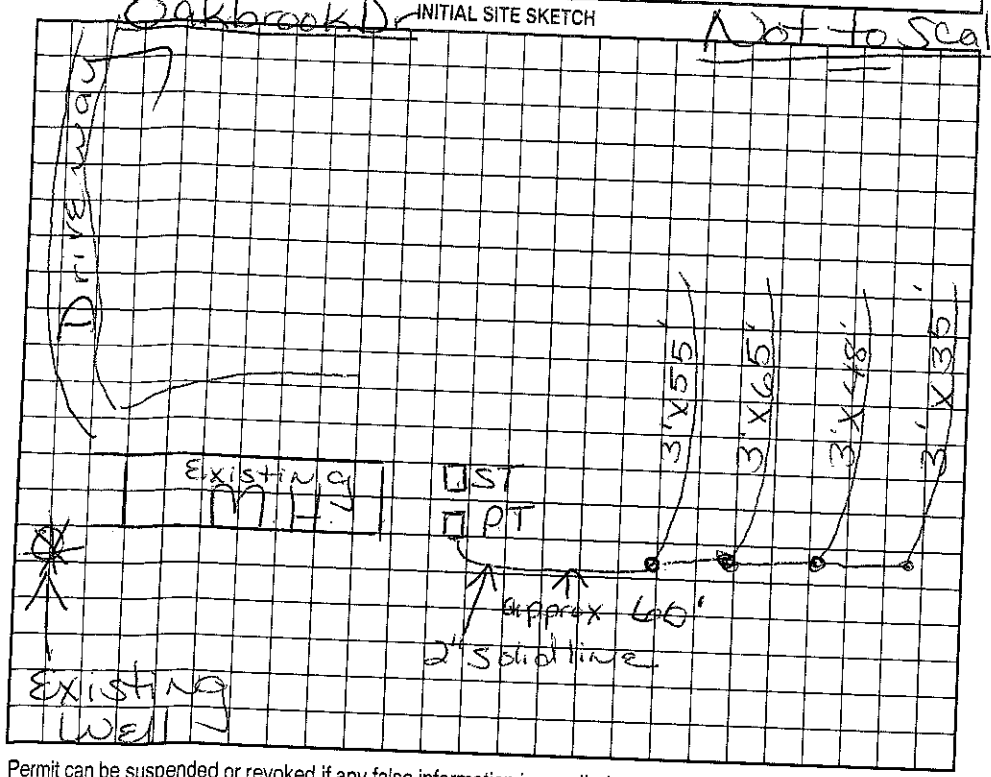

AS BUILT SKETCH

Permit can be suspended or revoked if any false information is supplied toward securing the permit/any unauthorized changes are made to the site/any unauthorized changes are made in the installation of the system. Improvement Permit with plat valid without expiration. Improvement Permit with site plan valid for sixty months. Authorization to Construct is valid for a period equal to that of Improvement Permit – not to exceed sixty months.

Signed: Owens & Castle date

Improvement Permit by: Maria H. Dotson RS date 7/16/99

Authorization to Construct by: Maria Dotson date 7/16/99

Installed by:

Operation Permit by:

Existing System Inspection by: Maria H. Dotson RS date 7/16/99

HEALTH DEPT. COPY: WHITE OWNER COPY (FINAL): YELLOW OWNER COPY (INITIAL): PINK