04823

IREDELL COUNTY HEALTH DEPARTMENT

(SEPTIC TANK) IMPROVEMENTS PERMIT AND CERTIFICATE OF COMPLETION

(Ground Absorption Sewage Disposal System -- G. S. Chapter 130-Article 13C)

OWNER OR CONTRACTOR P.B.S. Realty DATE March 17, '89 PERMIT NO. _____

PHONE: Business _____ Home _____

LOCATION 1150 (Jimwood Road) TL 1153 (Brumley Rd.) TR 1st entrance into Quail Hill TR at Stop Sign ~500' on Rt. S. R. No. _____

SUBDIVISION NAME Quail Hill LOT NO. 69 SECTION OR BLOCK NO. _____

House ( ) (✓) Mobile Home (✓) Business ( ) Other ~~X~~ Relayout due to change in home location

No. Bedrooms 3 No. Bathrooms 2

Garbage Disposal Unit Yes ( ) No (✓)

Auto. Dishwasher Yes (✓) No ( )

Auto. Wash. Machine Yes (✓) No ( )

Site ~~Suitable~~ YES Yes (✓) No ( )

Lot Area 5 Ac. M.H

Character & Porosity of Soil clay


Percolation Rate n.28

Topography Gently

Depth to Water Table 4'+

Rock or other impervious formations none obs.

_____ Basement with Plumbing 10' Basement without Plumbing ✓ No Basement

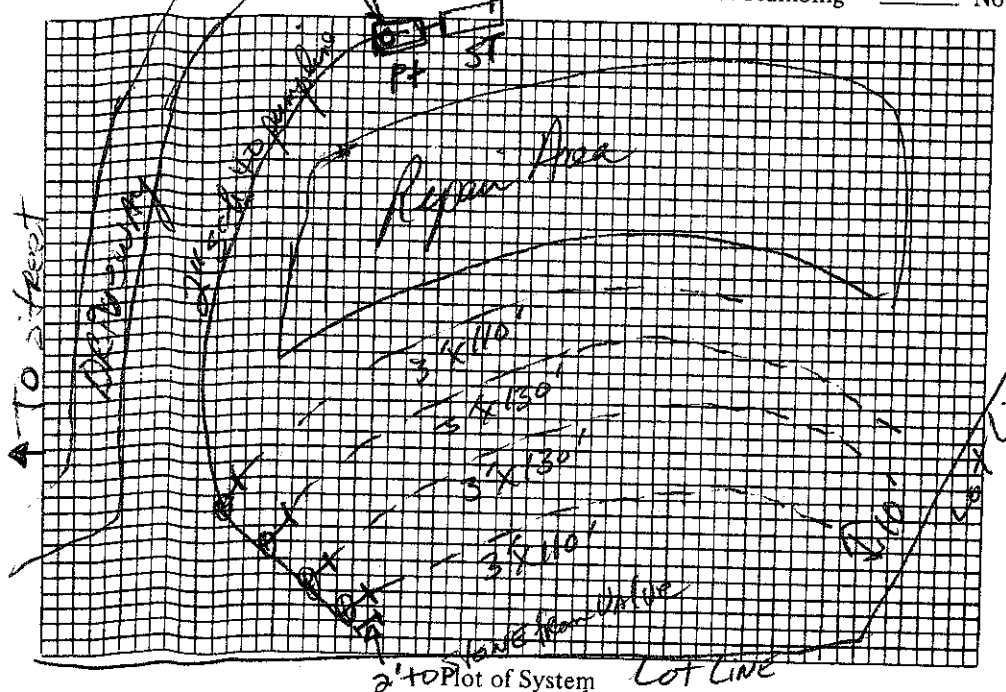

1000 p.t.

Size of Tank 1000 Gals.

Nitrification Field:

No. of Lines 4

Sq. Ft. 1440 Linear Ft. 480

Depth of Stone in Lines 12"

Water Supply: Individual (✓)

Public ( )

Installed by _____

I understand and agree to install septic tank system as specified on this Improvements Permit.

Signed ~~X~~ C. L Marion

IMPROVEMENTS PERMIT BY J. Henson R.S.

COMMENTS: Trench bottom depth on all lines of 24". Follow contour as laid out. Use 2" Sch 40 pump line and "Feeoff" at each ditch to a 1½" ball valve and 1½" lateral with one 5/32" hole drilled every 5 feet. Two foot pressure head on ditch. Pump specs: 40 gal/min at ~22' TDH.

CERTIFICATE OF COMPLETION BY _____ DATE _____

EXISTING SYSTEM CHECKED BY: _____ DATE _____

CONSTRUCTION MUST COMPLY WITH ALL OTHER APPLICABLE STATE AND LOCAL REGULATIONS.

Permit is VOID if any unauthorized changes are made in installation of system and/or if any false information is supplied in making Improvements Permit.

Health Dept. Copy: White Inspection Dept. Copy: Yellow Sanitarian's Copy: Pink Owner's Copy: Gold