IREDELL COUNTY HEALTH DEPARTMENT

STATESVILLE 704-878-5305 MOORESVILLE 704-664-5281

IMPROVEMENT PERMIT / AUTHORIZATION TO CONSTRUCT / OPERATION PERMIT / EXISTING SYSTEM INSPECTION

PERMIT# 075731 PIN# 4676 45 6174 DATE 8/10/98

OWNER OR CONTRACTOR Arthur Owens PHONE: Business Home 664-3969

ADDRESS 188 Oakbrook Dr. Mooresville, NC. 28115

LOCATION 152 E TR Brumley Rd. TL 2nd entrance (Woodwinds) 1st stop TR 4th drive on R

SUBDIVISION Quail Hill BLOCK / SECTION 4 LOT 68 LOT AREA 2.13 Ac. SITE CLASS. RS DESIGN FLOW 360 L.T.A.R.

Septic Tank: Existing Gallons; STB Date

Pump Tank: Existing Gallons; PT Date

Pump Make: Model Serial No.

Nitrification Field: No Fields Square Feet Existing Linear Feet 300

No Lines 4 Trench Width Max Trench Bottom Depth Gravel Depth

☐ New System ☐ Repair System Type: I, II, III, IV, V, VI

System Description: EXISTING - Press - T+T

Repair System Description: SAME

Maintenance Agreement Required: ☐ Yes ☐ No

☒ House/Mod. Home No. Bedrooms 3

☐ Mobile Home No. Bathrooms 3

☐ Business No. Employees

☐ Other

☐ Slab ☒ Crawl Space ☐ Basement w/plumbing ☐ Basement wo/plumbing


Water Supply: ☒ Individual ☐ Public ☐ Community

Comments:/Conditions:

Comments:/Conditions:

INITIAL SITE SKETCH

AS BUILT SKETCH

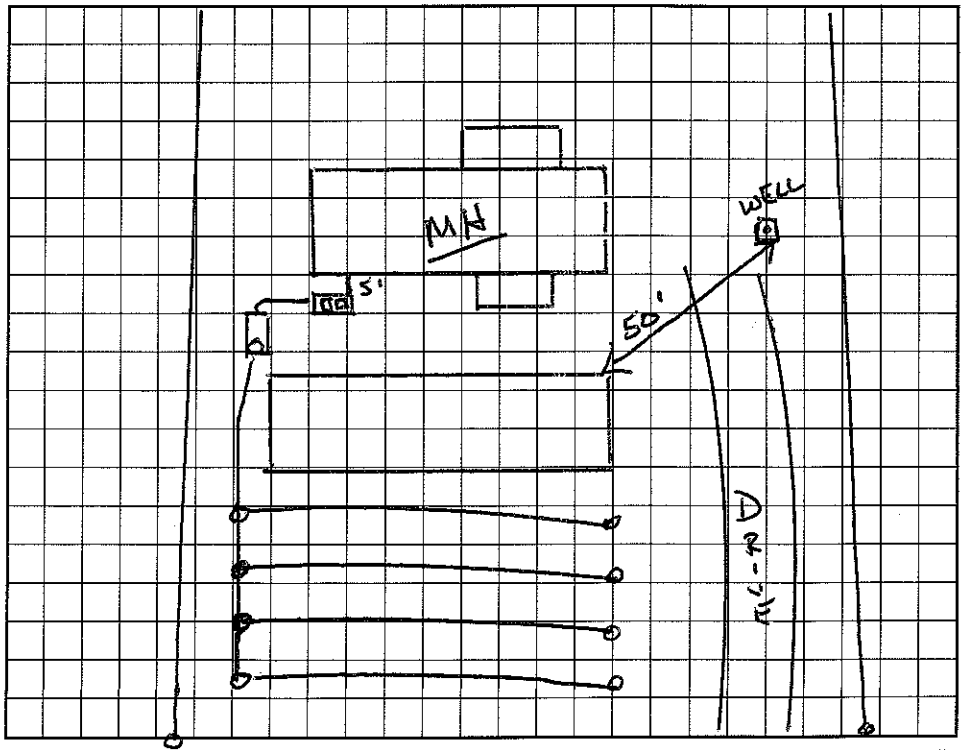

I understand that this permit can be suspended or revoked if any false information is supplied toward securing the permit/any unauthorized changes are made to the site/any unauthorized changes are made in the installation of the system. Improvement Permit with plat valid without expiration. Improvement Permit with site plan valid for sixty months. Authorization to Construct is valid for a period equal to that of Improvement Permit – not to exceed sixty months.

Signed: date

Improvement Permit by: date

Authorization to Construct by: date

Installed by: Dellinger

Operation Permit by: date

Existing System Inspection by: Wesley Sparks RS. date 8/10/98

HEALTH DEPT. COPY: WHITE INSPECTION COPY (FINAL): GREEN OWNER COPY (FINAL): YELLOW INSPECTION COPY (INITIAL): PINK OWNER COPY (INITIAL): GOLD